




Nov 11, 94
YOUNG FIELD

11:47

1-61

PLUGGING DATES

YEARS BETWEEN
SPUD & PLUG

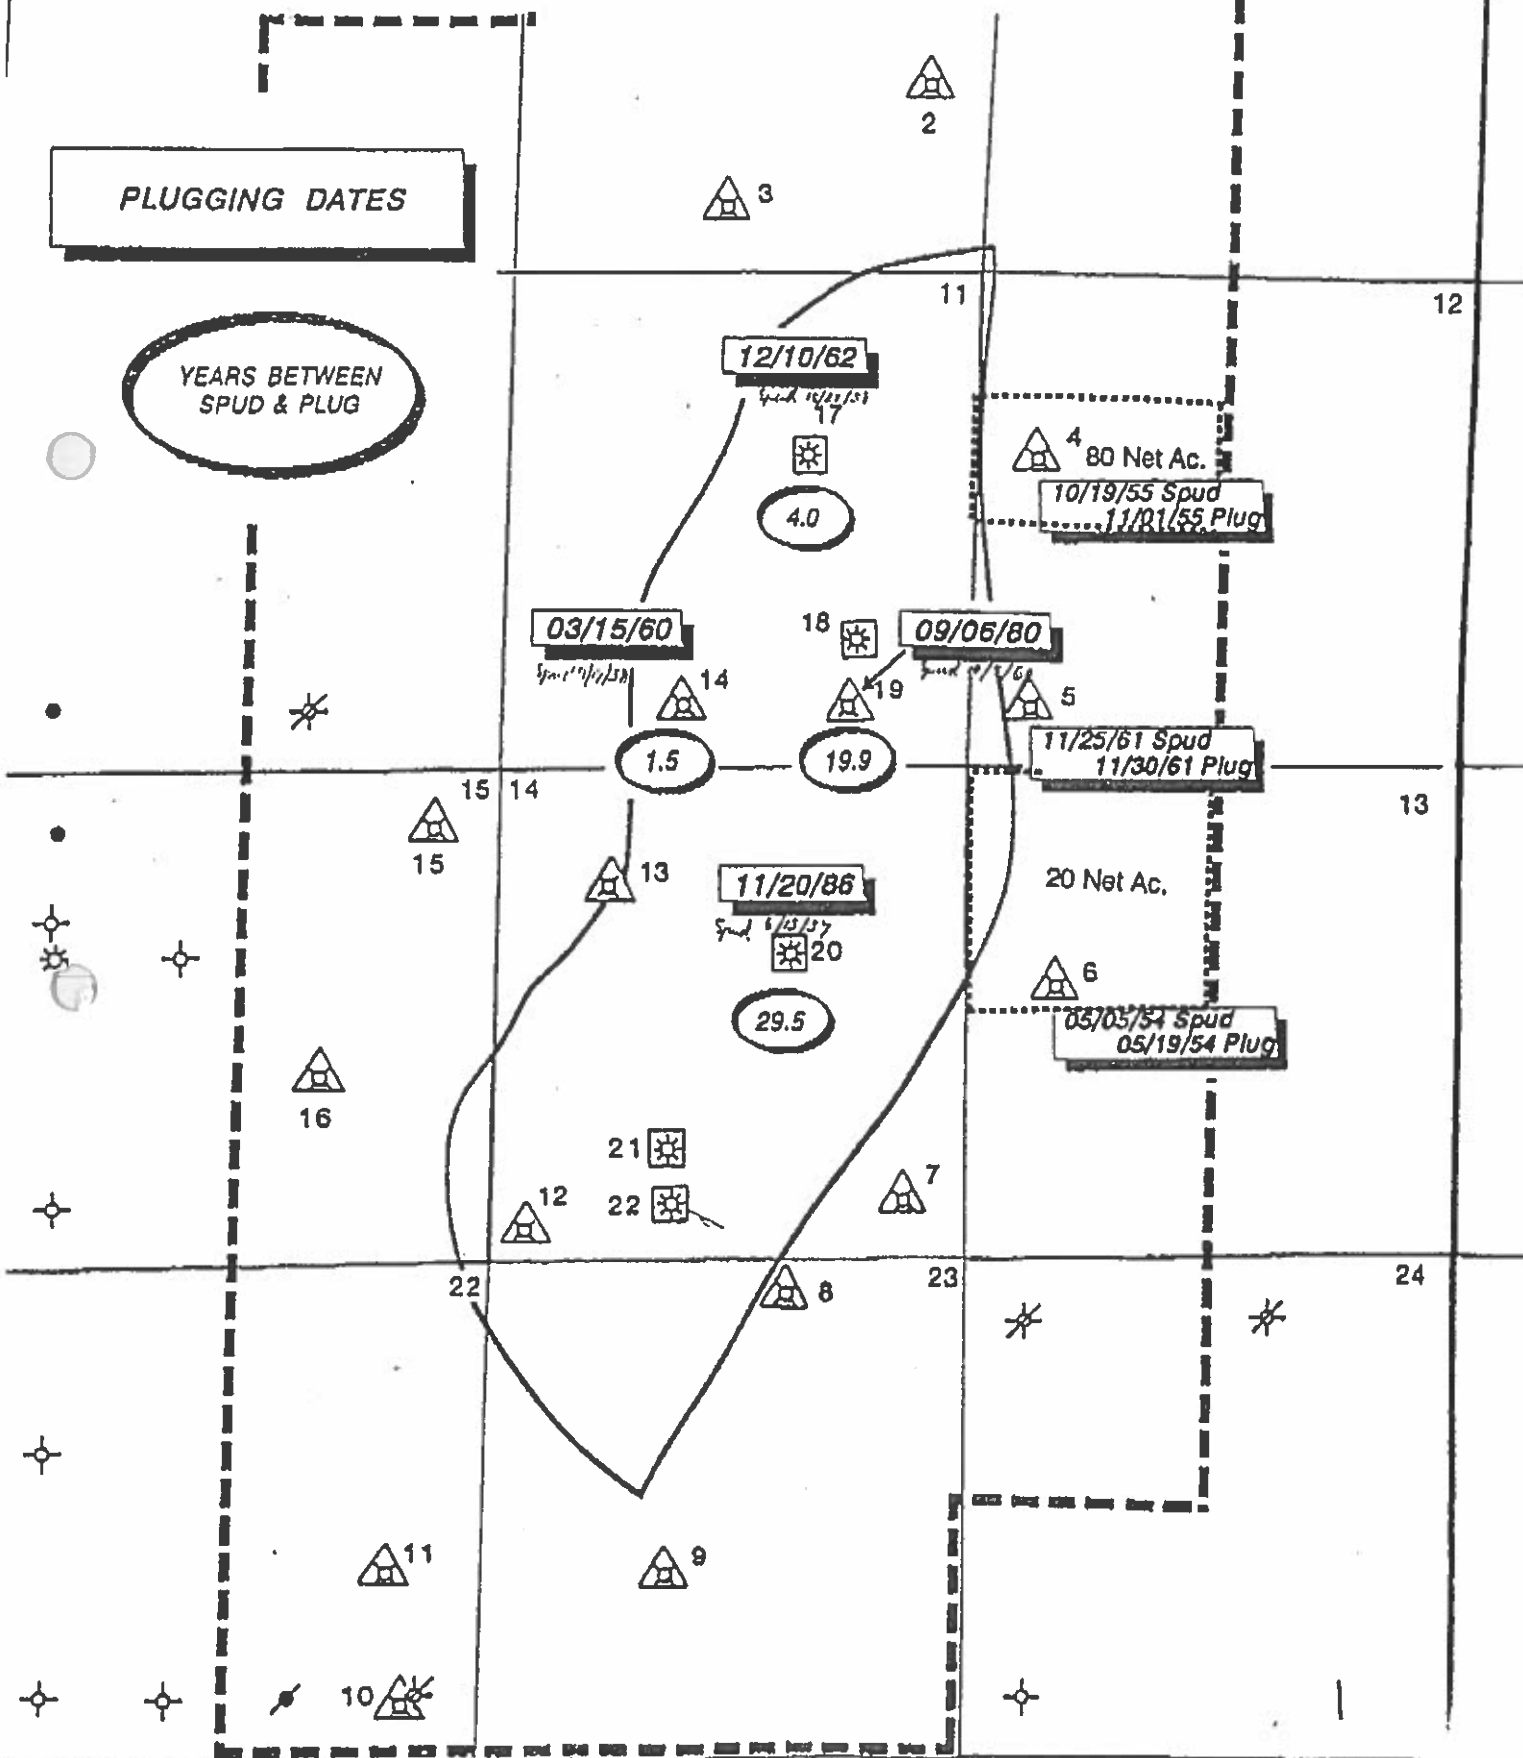

YOUNG FIELD

TOTAL PRODUCTION BY WELL

GAS (Mcf)
CONDENSATE (Bbls)

