


Well Name: SPIKE STATE D36-03

VERTICAL, ORIGINAL HOLE, 7/1/2019 3:41:10 PM

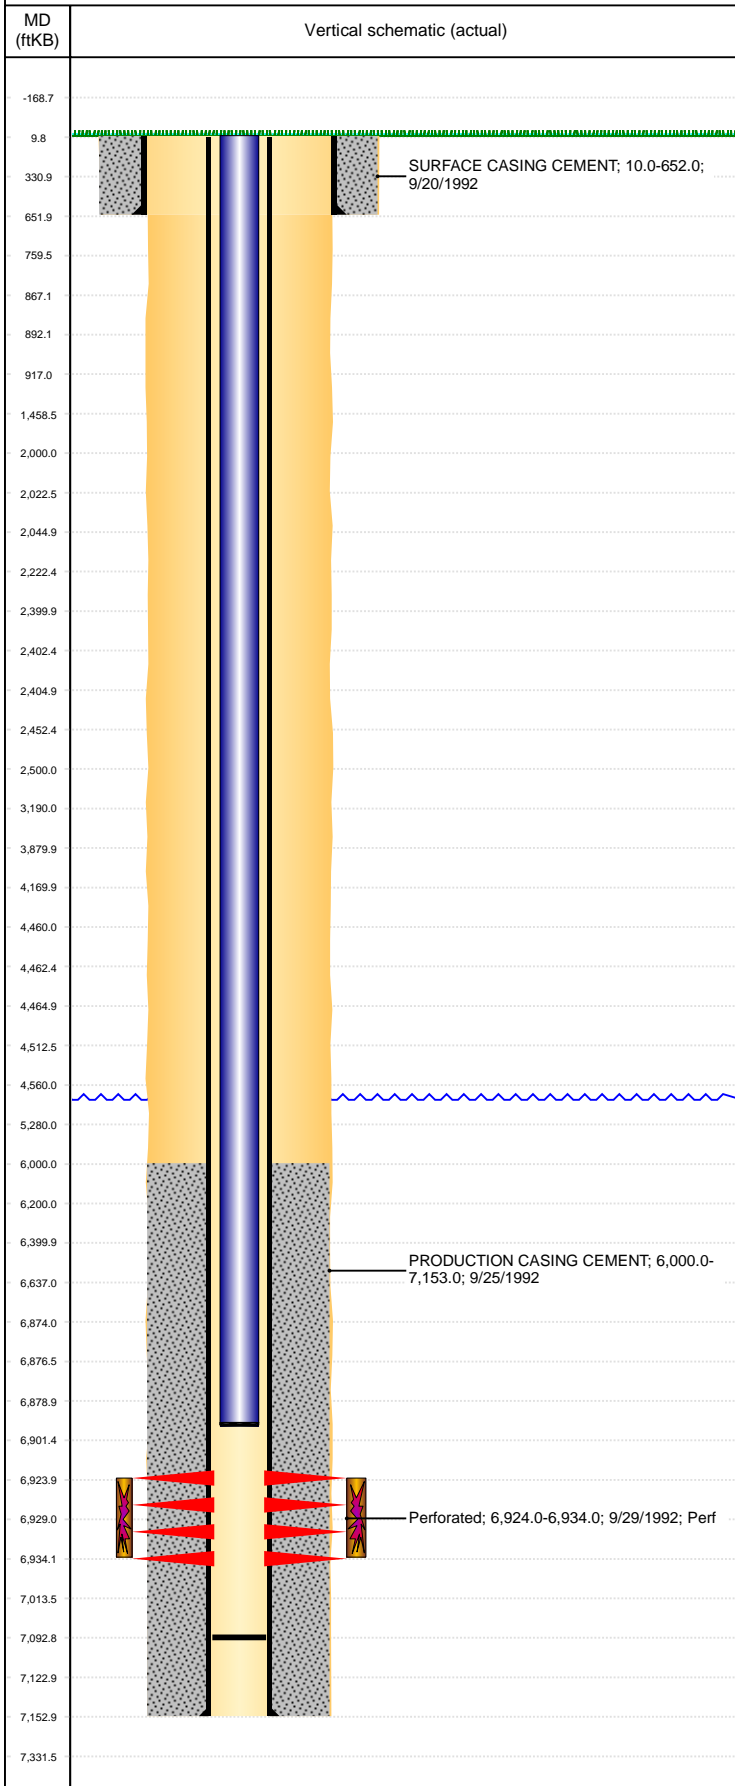

Well Header									
API 05-123-16128		Business Unit DJ BASIN			District 15		Well Config VERTICAL		
KB - GL / MSL (ft... 10.00		Spud Date 9/19/1992		P & A Date		Well Production Status SI			SoRT No
Comment TD DISCREPANCY - ST 7156', LOGGER TD 7159', WV 7153'.									
Surface Location (Congressional)									
Qtr 3 NE	Qtr 4 NW	Section 36	Twonshp 3	Twonsh... N	Range 64	Rng E/... W	Actual Latitude (°) 40.18694129	Actual Longitude (°) -104.50271301	
Wellbore Sections									
Section Des			Size (in)			Act Top, MD (ftKB)		Act Btm, MD (ftKB)	
SURFACE			12 1/4			10		652	
PRODUCTION			7 7/8			652		7,153	
Casing Strings									
Csg Des			Run Date		OD (in)	Wt/Len (lb/ft)	Grade	Top, MD (ftKB)	MD (ftKB)
Surface			9/20/1992		8 5/8	24.00	K-55	10.0	652.0
Production			9/25/1992		2 7/8	6.50	N-80	10.0	7,153.0
Cement									
Des					Start Date		Top (ftKB)		Btm (ftKB)
SURFACE CASING CEMENT					9/20/1992		10.0		652.0
PRODUCTION CASING CEMENT					9/25/1992		6,000.0		7,153.0
Zone Statuses									
Zone Name		Status Date	Status	Fluid Type	Job			Prod Method	
CODELL		4/1/2010	PR	Water				Flowing	
CODELL		5/9/2017	SI						
Perforation Data									
Linked Zone			Bnch/Stg	Entered Shot Total	Top (ftKB)		Btm (ftKB)		Date
CODELL, ORIGINAL HOLE				40	6,924.00		6,934.00		9/29/1992
Stimulation Intervals									
Zone				Start Date		Top (ftKB)		Btm (ftKB)	
CODELL, ORIGINAL HOLE				10/1/1992		6,924.0		6,934.0	
Other In Hole									
Run Date		Des				OD (in)	Top (ftKB)	Btm (ftKB)	
10/19/2015		Plunger Lift				1.27			
Logs									
Date		Type					Top, MD (ftKB)	Btm, MD (ftKB)	
9/23/1992		Compensated Density					6,150.0	7,170.0	
9/23/1992		Induction					6,150.0	7,170.0	
9/29/1992		Cement Bond					5,840.0	7,045.0	
Plug Back Total Depths									
Date		Type			Com				Depth (ftKB)
9/25/1992		LATCH DOWN COLLAR							7,049.0
7/10/2008					C/O FILL				7,093.0