# Federal PA 34-23

T. 6 S.

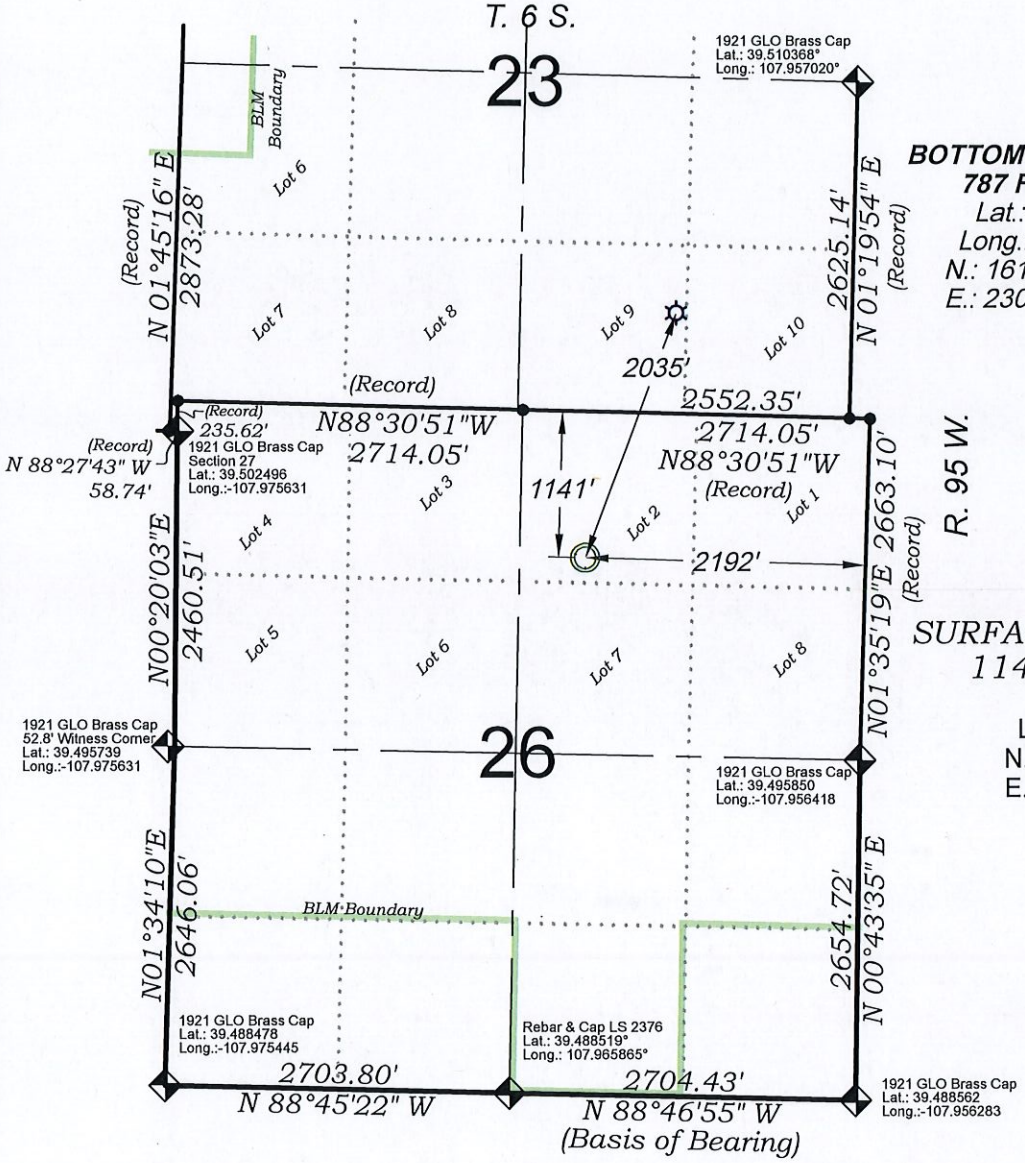


**BOTTOM HOLE LOCATION**
**787 FSL, 1380 FEL**
Lat.: 39.505317°
Long.: -107.961885°
N.: 1618352.1 (COSP)
E.: 2305431.9 (COSP)

0 750 1500
GRAPHIC SCALE IN FEET
1 INCH = 1500 FEET

SURFACE HOLE LOCATION
1141 FNL, 2192 FEL
Lat.: 39.500021°
Long.: -107.964184°
N.: 1616441.4 (COSP)
E.: 2304731.1 (COSP)

EXISTING GROUND ELEV.: 5484.3
PROPOSED PAD ELEV.: 5486.3

THERE ARE NO VISIBLE IMPROVEMENTS WITHIN 500' OF THIS LOCATION

## - LEGEND -

FIELD LOCATED SECTION MONUMENTS AS DESCRIBED

FIELD SURVEYED WELL LOCATION

CALCULATED BOTTOM HOLE LOCATION

CALCULATED SECTION CORNER LOCATION

## SURVEYORS STATEMENT

I, MICHAEL J. LANGHORNE, A REGISTERED LAND SURVEYOR IN THE STATE OF COLORADO DO HEREBY CERTIFY THAT THE SURVEY SHOWN HEREON WAS PREPARED UNDER MY DIRECT SUPERVISION AND HAS BEEN STAKED ON THE GROUND AS SHOWN ON THE PLAT AND CHECKING THAT THIS MAP IS A TRUE REPRESENTATION THEREOF.

MICHAEL J. LANGHORNE, COLORADO REGISTRATION NO. 36572
FOR AND ON BEHALF OF
BOOKCLIFF SURVEY SERVICES, INC.

## NOTES

1) ELEVATIONS BASED ON N.A.V.D. 1988 PUBLISHED COORDINATES.
2) LATITUDES AND LONGITUDES ARE BASE ON NAD 83, PUBLISHED COORDINATES
3) STATE PLANE COORDINATES ARE BASED ON COLORADO CENTRAL ZONE, U.S. SURVEY FEET.
4) ELEVATION MASK SET TO 15°
5) GPS OPERATOR J. KIRKPATRICK, OBSERVED A PDOP 2.6 ON SURVEY POINT NUMBER 96824.
6) SURFACE AND BOTTOM HOLE LOCATIONS ARE MEASURED 90° FROM SECTION LINES.

## REFERENCES

1) Resurvey of a Portion and Extension Survey of T. 6 S., R. 95 W., 6th P.M (GLO PLAT)
2) U.S.G.S. QUAD: ANVIL POINTS & RULISON, CO

REVISED: 6/07/18


136 East Third Street
Rifle, Colorado
81650 Ph. (970)
625-2720 Fax (970)
625-2773
BOOKCLIFF Survey Services, Inc.


| | |
|---|---|
| SURVEY DATE: | 6/11/15 |
| MAP DATE: | 1/05/18 |
| SCALE: | 1" = 1500' |
| PLAT: | 1 of 1 |
| PROJECT: | TEP Valley |

**WELL LOCATION PLAT Prepared for:**
TERRA ENERGY PARTNERS
TEP Rocky Mountain LLC

NW1/4 NE1/4, SECTION 26
T. 6 S., R. 95 W. of the 6th. P.M.
GARFIELD COUNTY, COLORADO