


Colorado Interstate Gas

LEASE: Young #16
FIELD: Young
COUNTY: Morgan
STATE: Colorado
LOCATION: 15 4N 58W
API #: 05-087-07112-00
SPUD: 03/23/69 [Original]
SPUD: 06/02/95 [Re-Entry]
Rev. Date 07/09/19 - APT

ELEVATION: GL: 4,515' KB = GL + 6'

TD: 6,053' GL PBTD: 5,999' GL

Size	ID
8-5/8	8.097
5-1/2	4.95

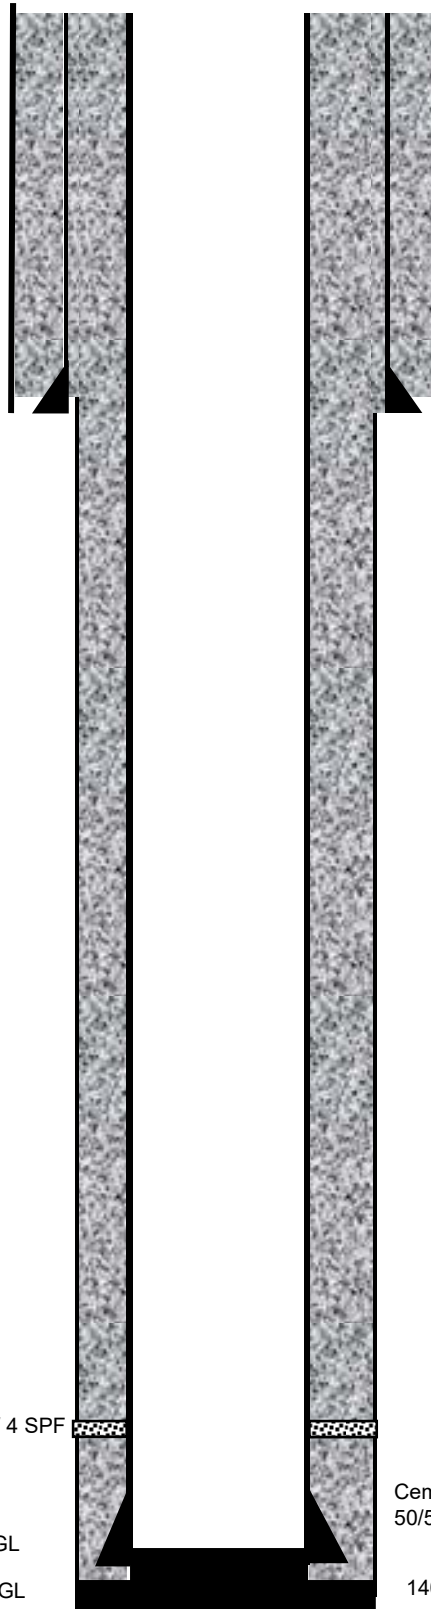

Cemented w/ 80 sx.

8-5/8", 24#, casing set @ 84' GL

TD 13" surface hole at 90'. Hole size and depth from original completion report

Perfs: 5,848' – 5,855' GL w/ 4 SPF

PBTD @ 5,999' GL

TD 7-7/8" hole @ 6,053' GL

Cemented w/ 1175 sx. HLC followed by 250 sx.
50/50 Poz. Cmt Circ.

140 jts, 5-1/2", 15.5#, K55, 8R, LT&C
casing set at 6047' GL