




RECEIVED

MAR - 2 1967

R. 69W

COLO. OIL & GAS CONS. COMM.

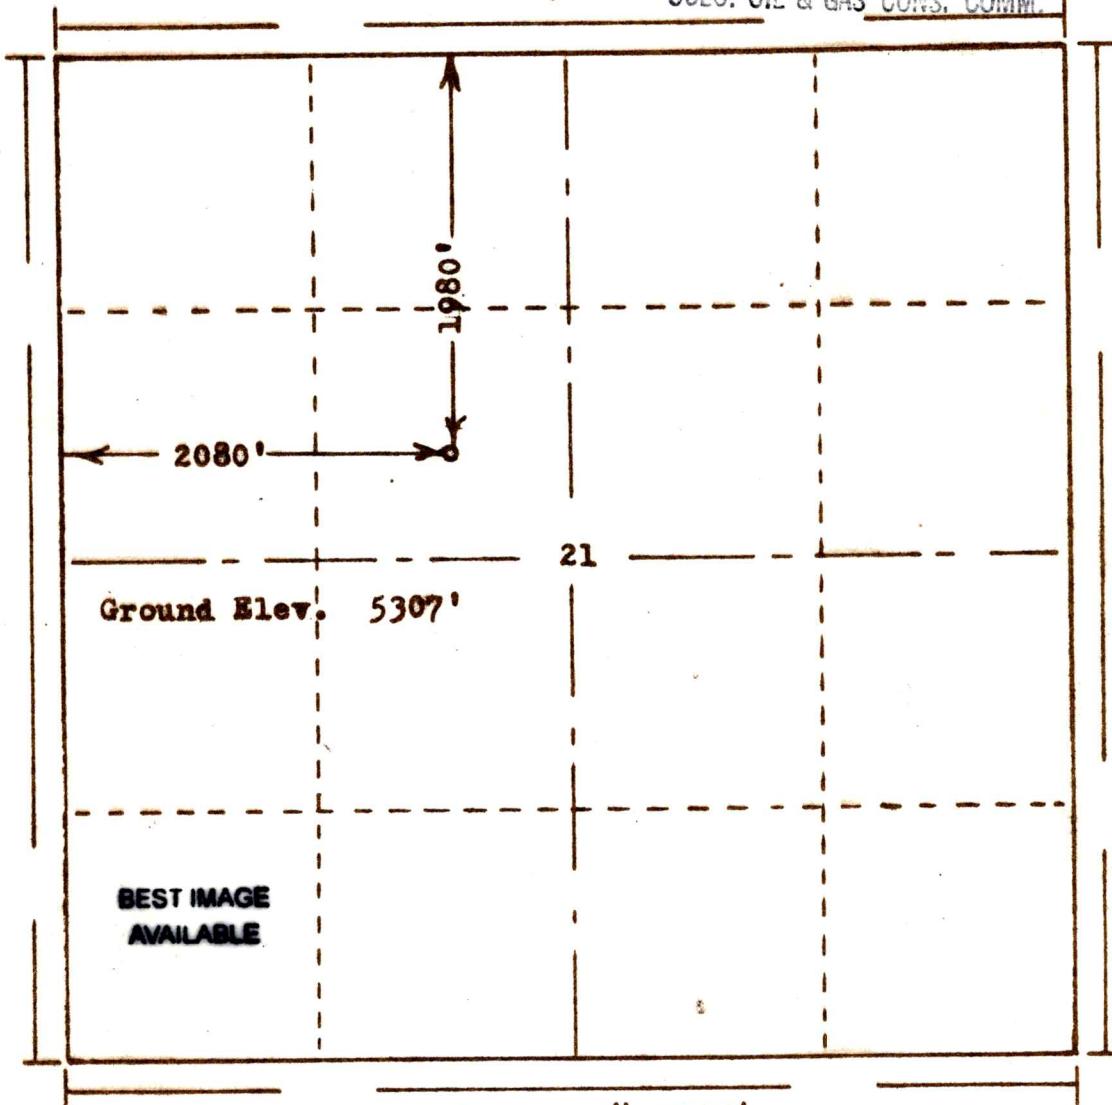

Scale ... 1" = 1000'

Powers Surveyors, Inc. of Denver, Colorado  
has in accordance with a request from Florence Johnston  
for Stuarco Oil Co., Inc. determined the  
Location of No. 1 Wessel et al  
to be 2080'FW & 1980'FN Section 21 Township 9N  
Range 69W of the 6th Principal Meridian  
Larimer County, Colorado

I hereby certify that this plat is an  
accurate representation of a correct  
survey showing the location of

Date: 2-12-67

*Florence Johnston*  
Licensed Land Surveyor No. 2853  
State of Colorado