




00266581

CERTIFICATE OF SURVEY
for
Patrick A. Doheny
Logan County, Colorado

RECEIVED
JUL - 6 1987
COLO. OIL & GAS CONS. COMM.

T10N R52W 6PM.

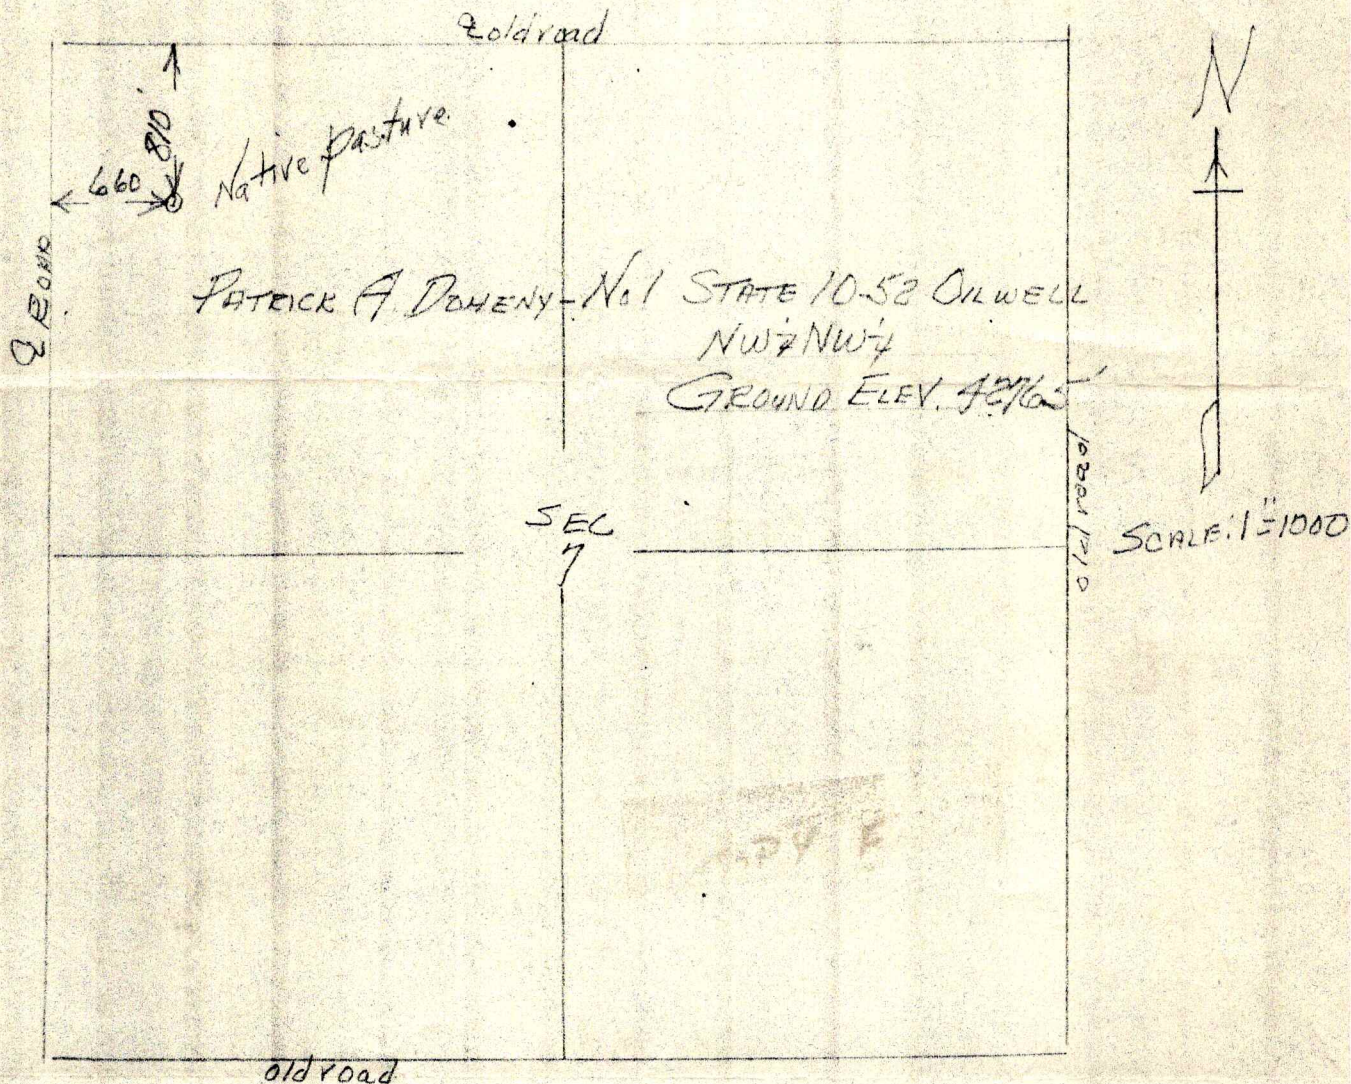

I hereby certify that the above plat is an accurate representation of a correct survey showing the location of Patrick A. Doheny-No. 1 State 10-52 Oilwell in NW 1/4 NW 1/4 Sec. 7 T10N R52W 6PM. The elevation of the ground at the stake is 4276.5 feet above sea level from U.S.G.S. Bench Mark.

Fort Morgan, Colorado
June 18, 1987

Robert J. Catome
Registered Professional Engineer
State of Colorado