

# Champlin #86 Amoco F #4

General Location:


Nwse-4-1N-68W

Latitude/Longitude: N40.07856400, W -105.00605200:

County: Weld, State: CO

Spud Date: 11/27/1981

Total Depth: 5292

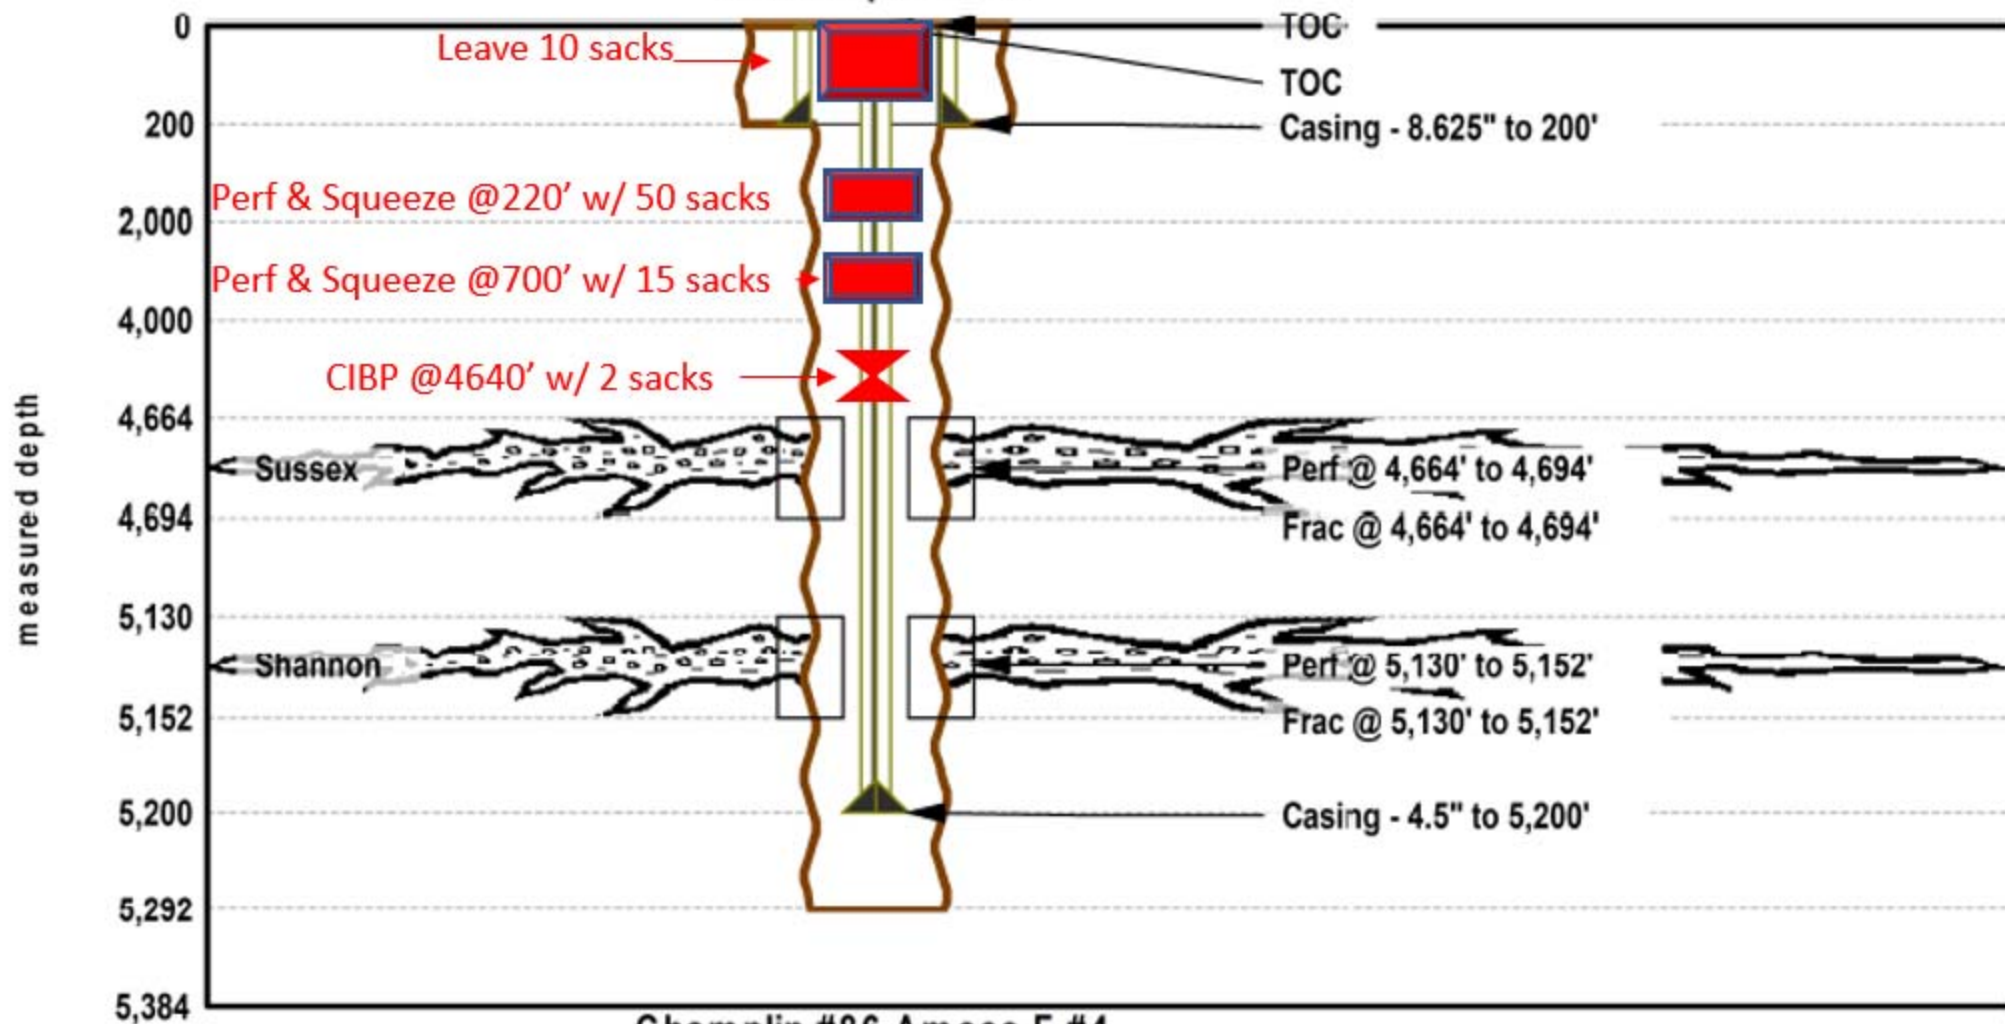

Champlin #86 Amoco F #4

Initial Completion: 1/20/1982

Proposed Depth: 0 Plug Back Depth: 5245