

Champlin #86 Amoco F #5

General Location:


Senw-4-1N-68W

Latitude/Longitude: N40.08201500, W -105.01076300:

County: Weld, State: CO

Spud Date: 12/3/1981

Total Depth: 5195

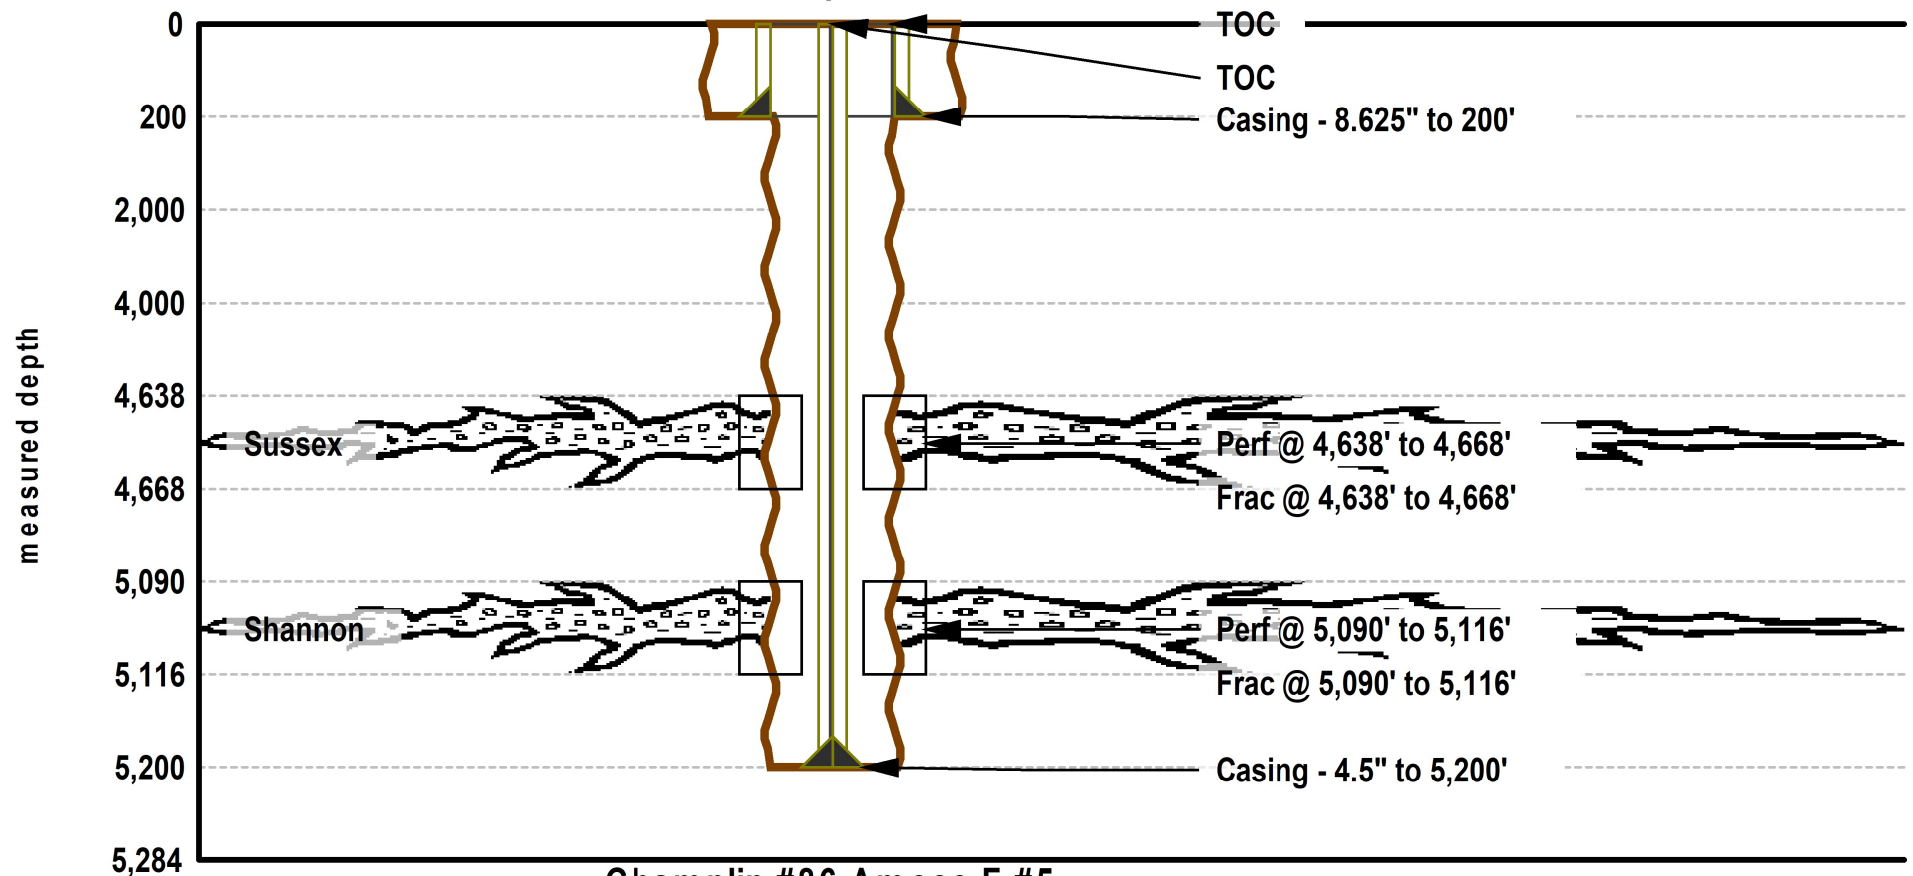

Champlin #86 Amoco F #5

Initial Completion: 4/4/1982

Proposed Depth: 0 Plug Back Depth: 5170