01081619

BOULTER 15-21

Prima Oil & Gas Co.

7/7/2000
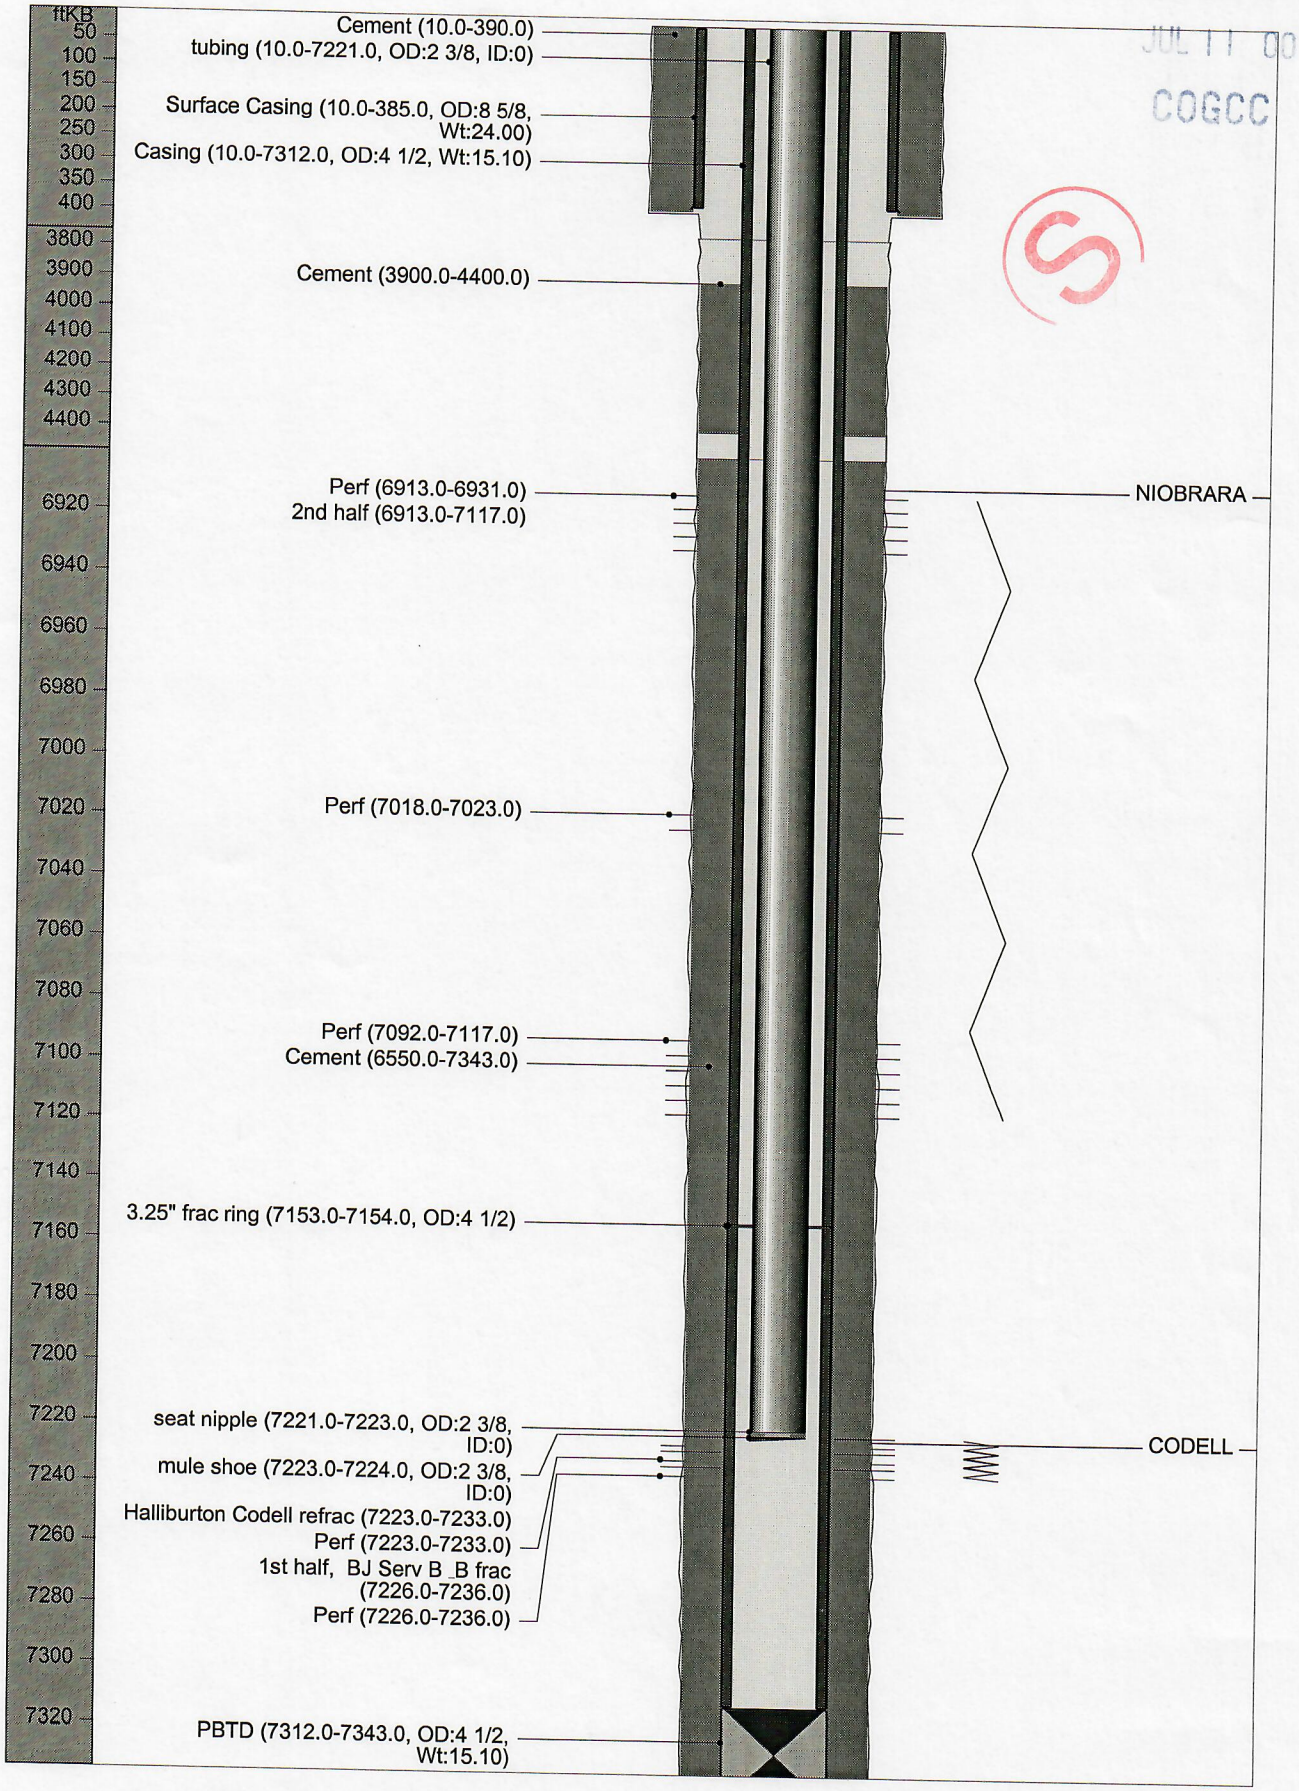
RECEIVED
JUL 11 '00
COGCC