




## Well Completion Diagram

API Well No: 05-009-05325-00-							
Owner:	SANDLIN OIL CORP			Well Name:	HOMSHER A		
County:	BACA	Field:	MIDWAY	Pool:			
Coordinates: X	1980 FEL	Y	660 FSL	Sec:	15	Twp:	33S Rng: 42W

Note: Changes to the drawing do not effect the database

## Bore Diameters (in.)

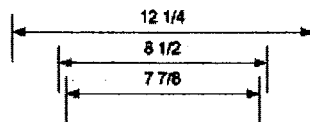

Cement Top: 0' mthd:U

\* Tubing 0'

Leak in casing just below surface

Holes in casing 1171-2340

8 5/8" SURF 1,479'

4 1/2" 2ND 1,512'

Cement Top: 1,512' mthd:U

1-12. > squeeze 150SX  
1567

Cement Top: 2,720' mthd:U

Perfs. 3,046-3,056'

Cement Top: 3,118' mthd:U

3040 - cement retainer

2046-3056 - squeeze w/ 200 SKS

3112'-3118' Reperf 3046-3056 producing

Perfs. 3,118-3,624'

4 1/2" 1ST 3,845'

Total Vertical Depth 3,860'