

**Current Well Completion Diagram**

**API Well No. 05-001-09302**

**Operator: McCartney Engineering, LLC**


**Well Name: HSR-Fulenwider #12-10**

**Banner Field, Adams County, Colorado**

**Coordinates: 1920' FSL, 900' FWL NWSW Sec. 10-T2S-R66W 6th PM**

**7-Jun-18**

**Bore Diameters (inches)**

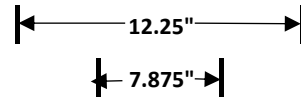

**Cement Top 0'**  
**8 5/8" 24# Csg @ 1677' KB**  
**Cemented to Surface**

**Cement Bottom 1677' KB**

**Cement Top 7126' (bond log)**

**Top Niobrara @ 7550'**

**J Sand Perforations 8334' - 8371'**

**PBTD = 8458'**  
**4 1/2" 11.6# @ 8471' Cemented with 260 sxs**  
**TD = 8486'**

