

BEST IMAGE
AVAILABLE

RECEIVED
MAY 10 1955
GAS COMMISSION



COMPANY EL PASO NATURAL GAS COMPANY

Well Name & No. G. SWIFT NO. 1

Lease No. FREE


Location 660 FEET FROM THE NORTH LINE, 660 FEET FROM THE EAST LINE

Being in NE 1/4 OF THE NE 1/4

Sec. 6, T 24S, R 51W, 6TH. P.M.

BENT COUNTY, COLORADO

Ground Elevation 4091⁵

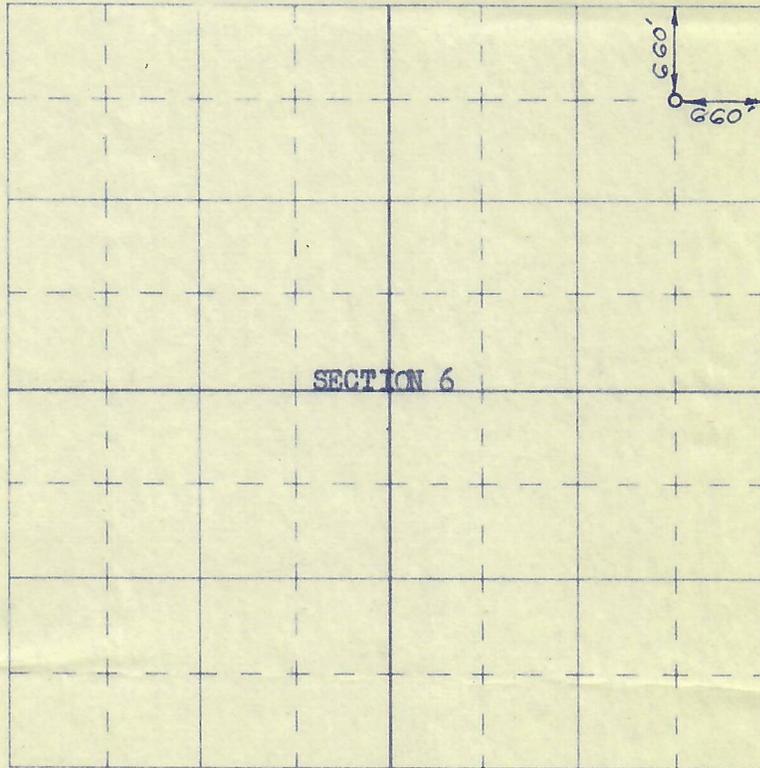

Scale -- 4 inches equals 1 mile

Surveyed MAY 5, 19 55

This is to certify that the above plat was prepared from field notes of actual surveys made by me or under my supervision and that the same are true and correct to the best of my knowledge and belief.

Clarence Olin Walker
Registered Professional
Engineer and Land Surveyor.

