


Well Completion Diagram

API Well No: 05-125-06104-00-							
Owner:	MOUNTAIN PETROLEUM CORP			Well Name:	SCHMIDT		
County:	YUMA	Field:	PHUMA	Pool:			
Coordinates: X	1320 FWL	; Y	1320 FNL	Sec:	2	Twp:	5N Rng: 46W

Note: Changes to the drawing do not effect the database

Bore Diameters (in.)

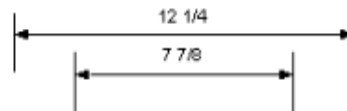

Cement Top: 0' mthd:U

Cement Top: 0' mthd:U

8 5/8" SURF 374'

Perfs. 2,654-2,660'

4 1/2" 1ST 2,765'

Total Vertical Depth 2,765'

