

Davis Oil Company
1424 10th Street
Rock Springs, Wyoming 82901
Job No. 80 DVIS 18

March 12, 1980

PETERSEN & STRAIN SURVEYING, INC.


12 West Sixth Street
La



00575152

MAR 31 1980

COLO. OIL & GAS CONS. COMM.

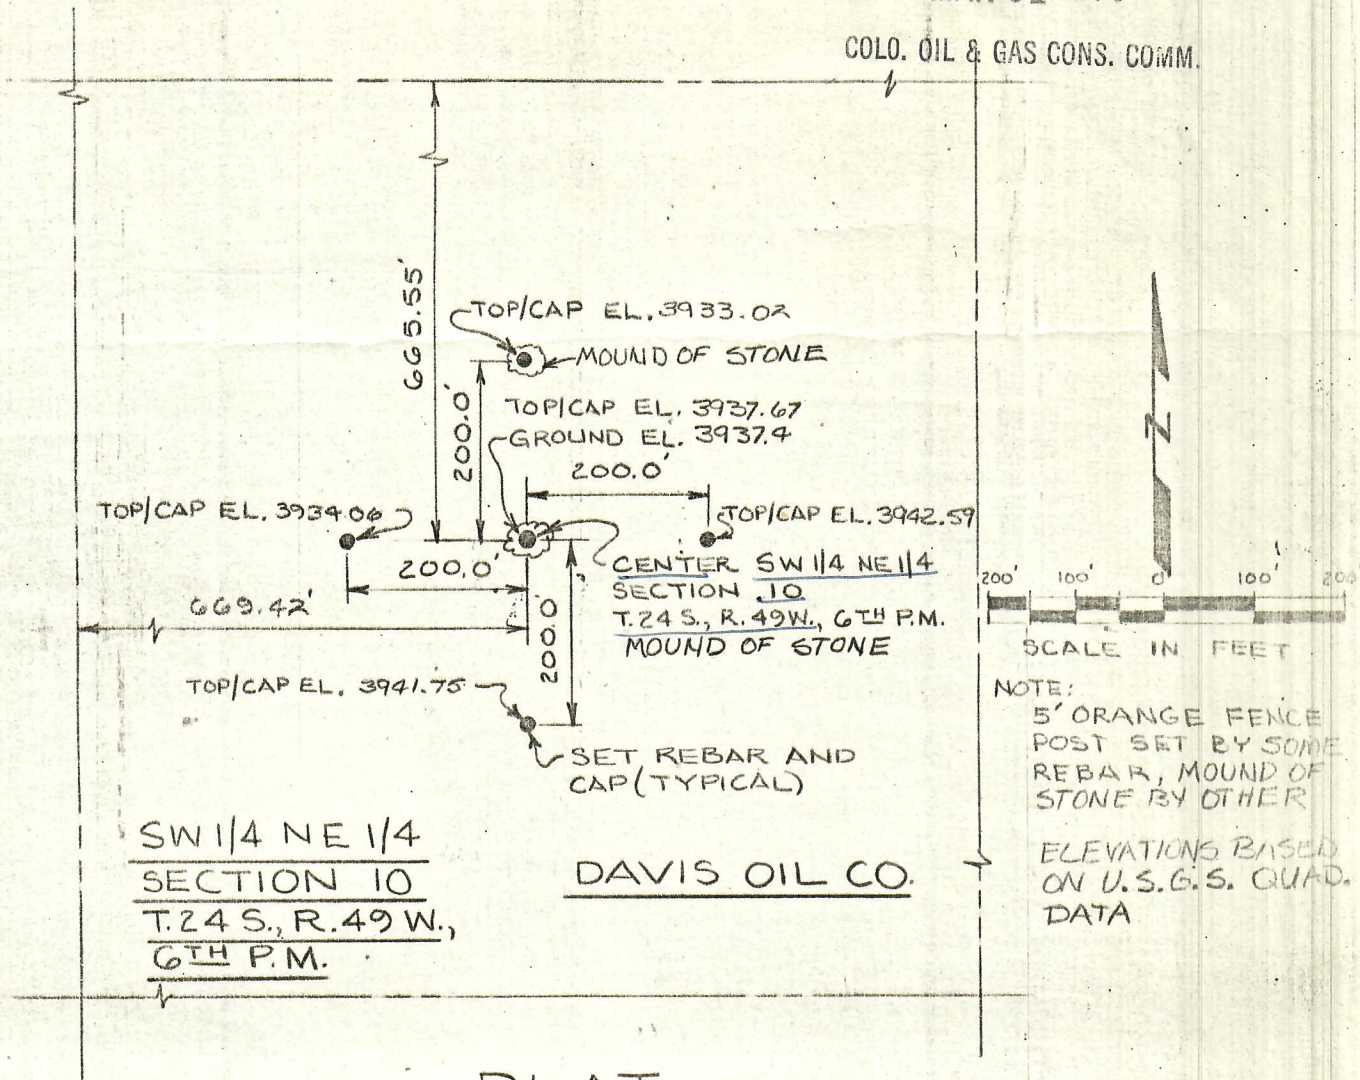

SW 1/4 NE 1/4
SECTION 10
T.24 S., R.49 W.,
6TH P.M.

DAVIS OIL CO.

PLAT

1"=200'

SNIFF RANCH #1

LEGAL DESCRIPTION

The center of the SW 1/4 NE 1/4, of Section 10, T.24S., R.49W., 6th P.M. Bent County, Colorado.


CERTIFICATE OF SURVEY

March 12, 1980

I, PHILIP L. PETERSEN, a Registered Land Surveyor in the State of Colorado, do hereby certify that on March 10, 1980, the hereon shown tract of land was surveyed and its corners set under my supervision; that this plat was prepared under my direction and accurately represents the survey made.

Philip L. Petersen

Philip L. Petersen
Registered Land Surveyor
Colorado 12103

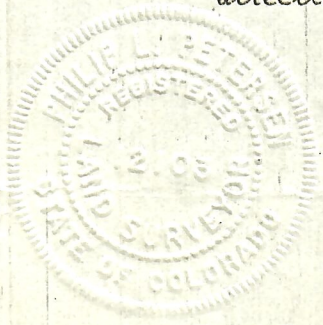

BEST IMAGE
AVAILABLE