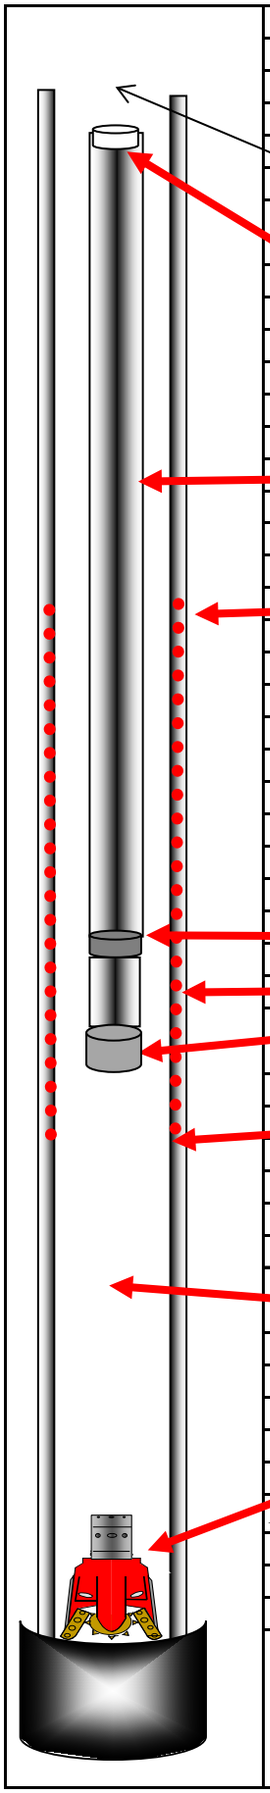

COMPANY	Laramie Energy LLC	05-045-21014-0000	CASING	LINER	TUBING
WELL NAME	CC 697-04-06W	SIZE:	4.5		2.375
FIELD	CC 604-12-13	WEIGHT:	11#		4.7#
COUNTY	MESA	GRADE:			L80
STATE	COLORADO	THREAD:			8rd EUE
DATE	Friday, August 02, 2019	DEPTH:		EOT w/KB	8,873.02
					LENGTH
ITEM	DESCRIPTION		OD	ID	FEET
	K.B.				30.00
	Tubing Hanger Cameron 7 1/16" 5K Hanger		7.063	1.901	0.86
	267 JTS 2 3/8" 4.7# EUE L-80		2.375	1.901	8,807.56
	TOP PERF 7372'				
	Zones: Cameo, Williams Fork				
	Baker F-Nipple 1.810"		3.125	1.810	0.84
	1 JT 2 3/8" 4.7# EUE L-80		2.375	1.901	33.13
	1/2 POBS		3.250	2.000	0.63
	BOTTOM PERF 9398'				
	1/2 POBS & 3 3/4" mill @ 9,525'				
P.B.T.D			**EOT w/ K.B.**		**8,873.02**

PREPARED FOR: