


Colorado Interstate Gas

LEASE: Latigo #41
FIELD: Latigo
COUNTY: Arapahoe
STATE: Colorado
LOCATION: 24 5S 61W
API #: 05-005-06373-00
SPUD DATE: 04/19/79
Rev. Date 08/20/19 - APT

ELEVATION: GL: 5,462' KB: 0'
 TD: 6,842' GL PBTD: 6,810' GL

Size	ID
9-5/8	8.921
5-1/2	4.95
2-3/8	1.995
Seating Nipple	1.78

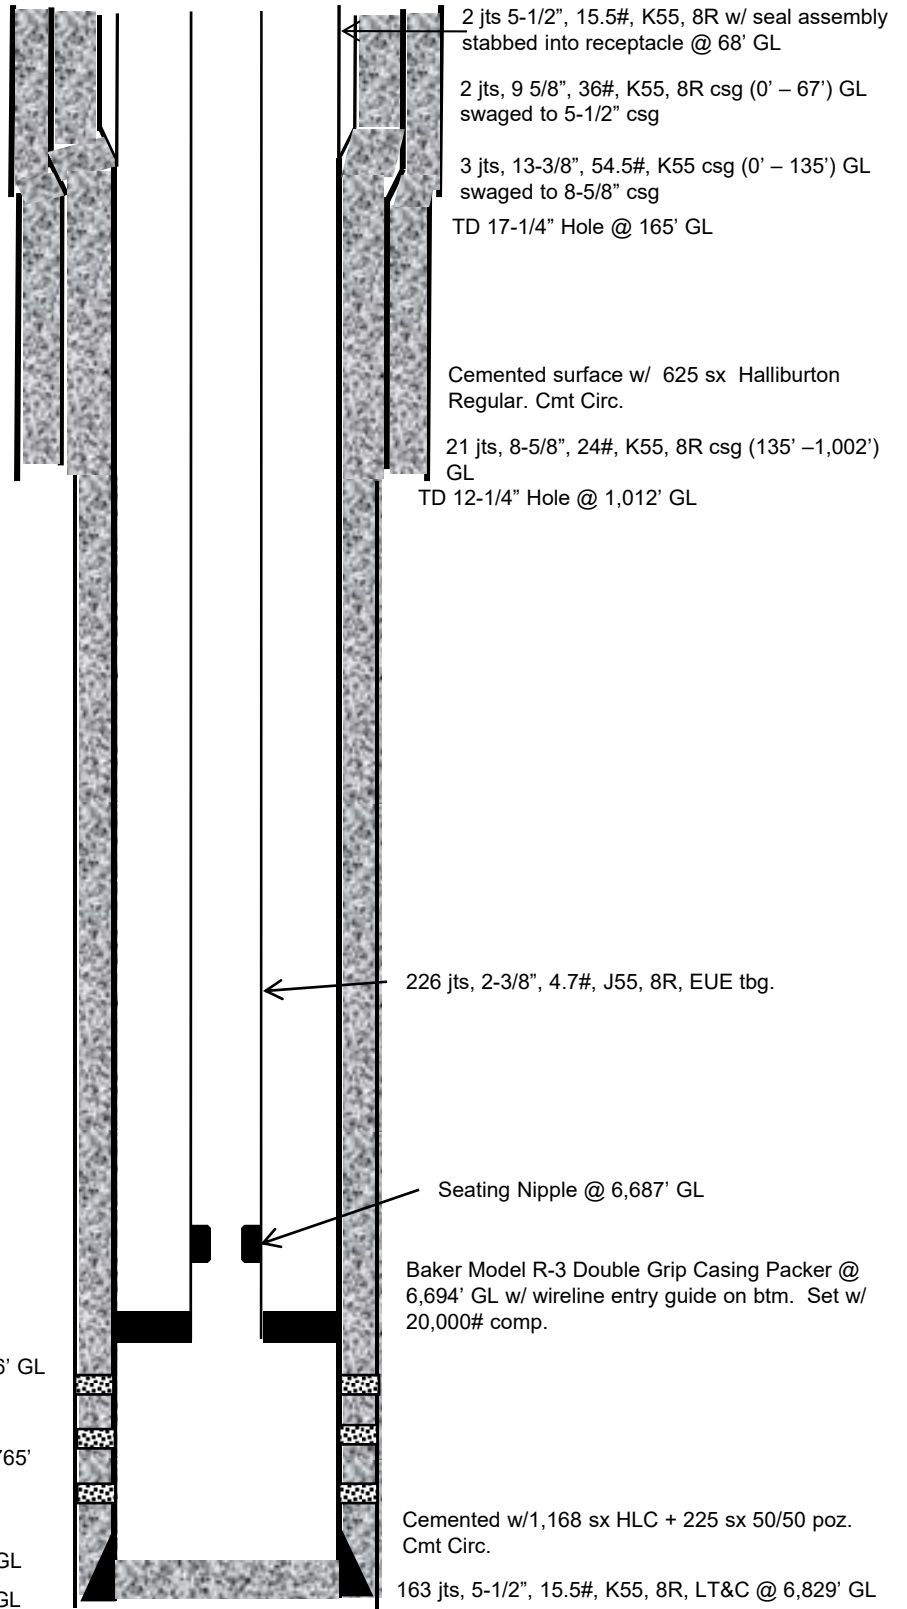

Re-Perf: 6,738'–6,754' GL, 6,756'–6,760', 6,762'–6,766' GL w/ 2 SPF (08/24/85)

[Original] Perf: 6,765'–6,756' GL w/ 2 SPF (05/22/79)

[Original] Perf: 6,738'–6,754', 6,756'–6,760', 6,762'–6,765' w2 SPF (05/23/79)

PBTD @ 6,810' GL
 TD 7-7/8" hole @ 6,842' GL