



Whiting Oil & Gas Corporation

Off-Location Flowline Layout Drawing

NW/SW Section 26 T10N R58W 6th P.M.


Flowline End Point Location: Produced Water Transfer System – No Facility ID

Flowline Start Point Location: Razor 26 CPB – Facility ID: 435421



Legend

- Produced Water Flowline
- Flowline Start Point
- Flowline End Point

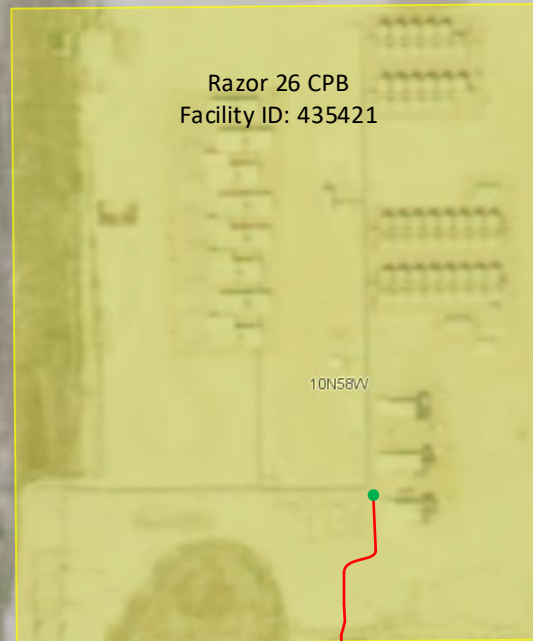

End Point
Produced Water Transfer System
No Facility ID

0 60 120 ft