


Colorado Interstate Gas

LEASE: Latigo #28
FIELD: Latigo
COUNTY: Arapahoe
STATE: Colorado
LOCATION: 24 5S 61W
API #: 05-005-06787-00
SPUD DATE: 03/27/78
Rev. Date 08/26/19 - APT

ELEVATION: GL: 5,436' KB: 0'
 TD: 6,820' GL PBTD: 6,800' GL

Size	ID
9-5/8	8.921
5-1/2	4.95
2-3/8	1.995
Seating Nipple	1.78

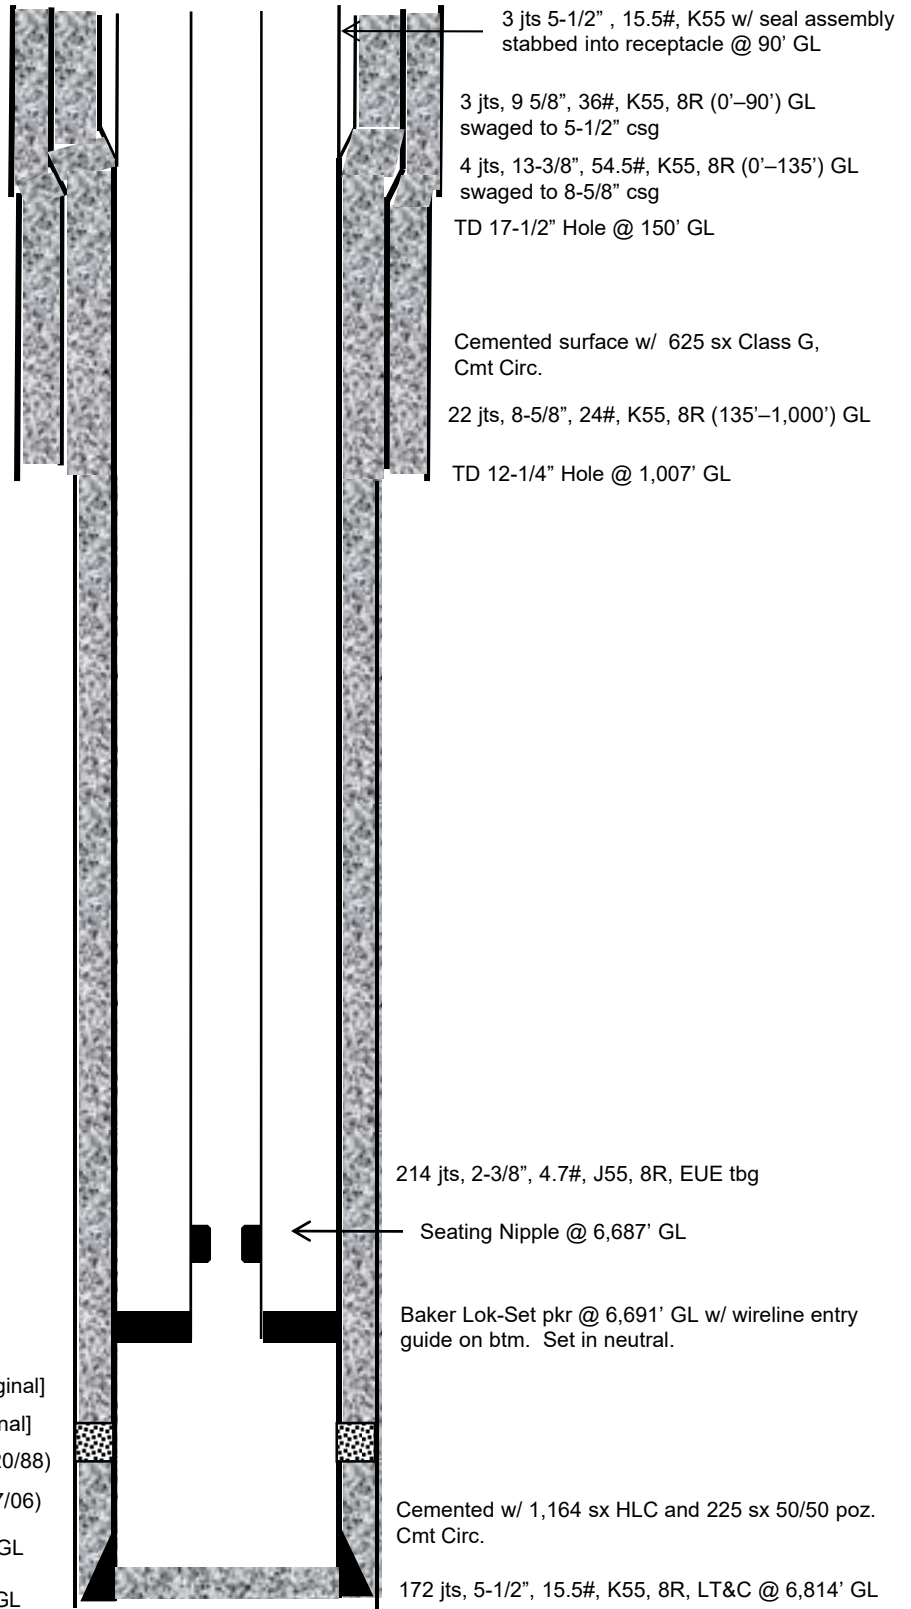

Perf: 6,714'-6,720' GL w/2 SPF [Original]
 Perf: 6,722'-6,730' GL w/2 SPF [Original]
 Perf: 6,716'-6,722' & 6,724'-6,736' GL w/2 SPF (07/20/88)
 Perf: 6,716'-6,736' GL w/4 SPF (09/07/06)
 PBTD @ 6,800' GL
 TD 7-7/8" hole @ 6,820' GL