

# Foundation Energy Management, LLC

## WELLBORE DIAGRAM

Well / Battery	Prospect Name		Total Depth	Current Status
MAURICE	Bonny		2,684	PR
Location	Sec-Twn-Rng		Producing Horizon	County & State
12-7	7-1N-45W		NIOBRARA	Yuma CO

## WELLBORE DIAGRAM

**Prepared Date:**

**Prepared By:** Mike Jumper

### General Info

API #: 05-125-09072

KB Elevation:

GL Elevation:

Spud Date:


Completion Date:

TVD:

MD:

Last PBTD:

### Tubing Detail

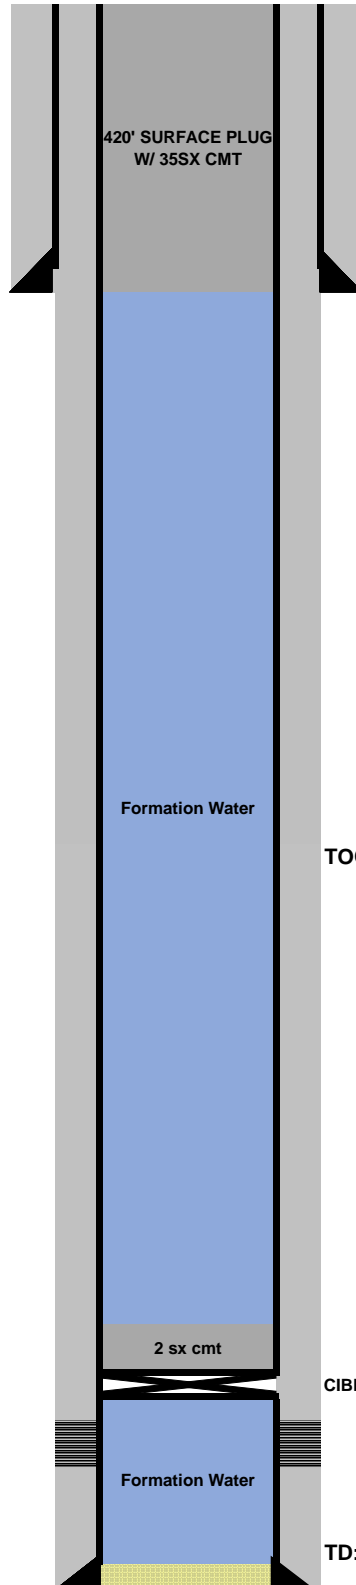

### Surface Casing

7" inch (OD)  
17 # (weight)  
grade  
420 depth from KB  
SURF cement top  
100 sacks of cement  
9-5/8" inch (OD) HOLE SIZE

### Production Casing

4-1/2" inch (OD)  
11 # (weight)  
grade  
2,500 depth from KB  
SURF cement top  
250 sacks of cement  
6-1/4" inch (OD) HOLE SIZE

TOC:

Pump Details:  
none

Pumping Unit Details:

Well Notes:

CIBP @ 2,410'

**Perforations**  
2,460-2,490

TD: