

Foundation Energy Management, LLC

WELLBORE DIAGRAM

Well / Battery	Prospect Name	Total Depth	Current Status
ROSE	Bonny	1870	PR
Location	Sec-Twn-Rng	Producing Horizon	County & State
3-17 3	17-2S-43W	NIOBRARA	Yuma, CO

CURRENT WBD


Prepared Date:
Prepared By: Mike Jumper

General Info

API #: 05-125-07402
 KB Elevation:
 GL Elevation:
 Spud Date:
 Completion Date:
 TVD:
 MD:
 Last PBTD:

Tubing Detail

inch(OD)
 # (weight)
 grade
 EOT

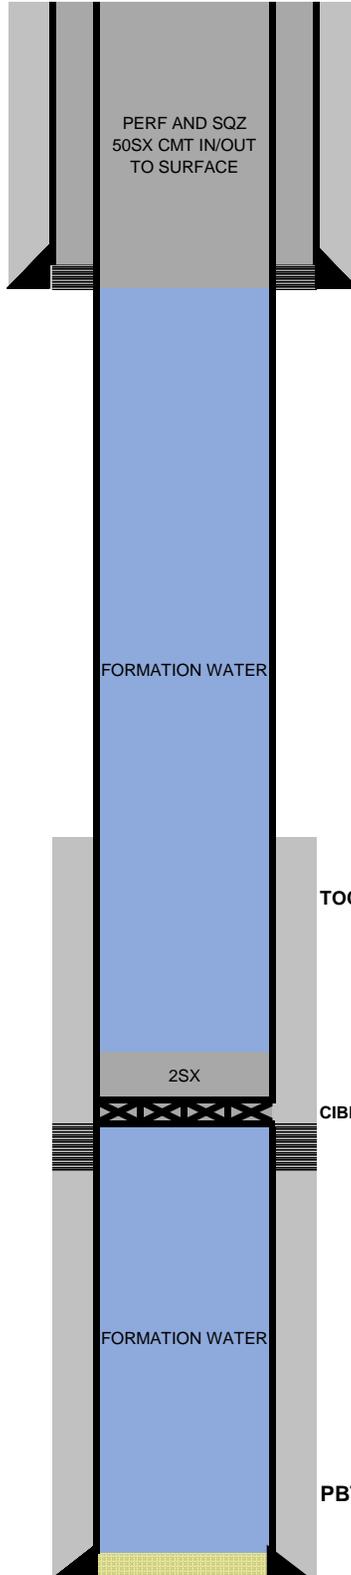

Surface Casing

7" inch (OD)
 17 # (weight)
 grade
 257 depth from KB
 SURF cement top
 120 sacks of cement
 9-5/8" inch (OD) HOLE SIZE

Production Casing

4-1/2" inch (OD)
 10.5 # (weight)
 grade
 1870 depth from KB
 1206 cement top
 70 sacks of cement
 6-1/4" inch (OD) HOLE SIZE

Open Perforations

1,673-1,720'