

# Foundation Energy Management, LLC

## WELLBORE DIAGRAM

Well / Battery	Prospect Name	Total Depth	Current Status
BLACH	Bonny	2714	PR
Location	Sec-Twn-Rng	Producing Horizon	County & State
1-24	24-1S-48W	NIOBRARA	Yuma, CO

### CURRENT WBD


**Prepared Date:**    
**Prepared By:** Mike Jumper

**General Info**

API #: 05-125-06159  
 KB Elevation:    
 GL Elevation:    
 Spud Date:    
 Completion Date:    
 TVD:    
 MD:    
 Last PBTD:  

**Tubing Detail**

inch(OD)  
 # (weight)  
 grade  
 EOT

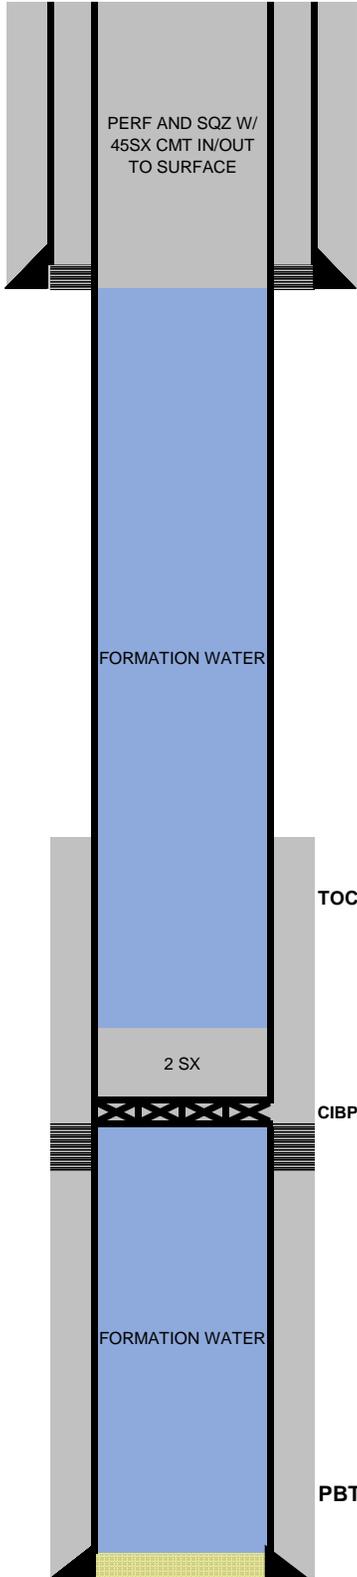

**Surface Casing**

7" inch (OD)  
 17 # (weight)  
 grade  
 237 depth from KB  
 SURF cement top  
 245 sacks of cement  
 9-5/8" inch (OD) HOLE SIZE

**Production Casing**

4-1/2" inch (OD)  
 10.5 # (weight)  
 grade  
 2714 depth from KB  
 1100 cement top  
 150 sacks of cement  
 6-1/4" inch (OD) HOLE SIZE

TOC: 1,100'

CIBP @ 2,480'

**Open Perforations**

2,530-2,576'

PBTD:

Pump Details:  
 none

Pumping Unit Details:

Well Notes: