




R. 45W

RECEIVED

AUG 8 1975

COLO. OIL & GAS CON. COMM.

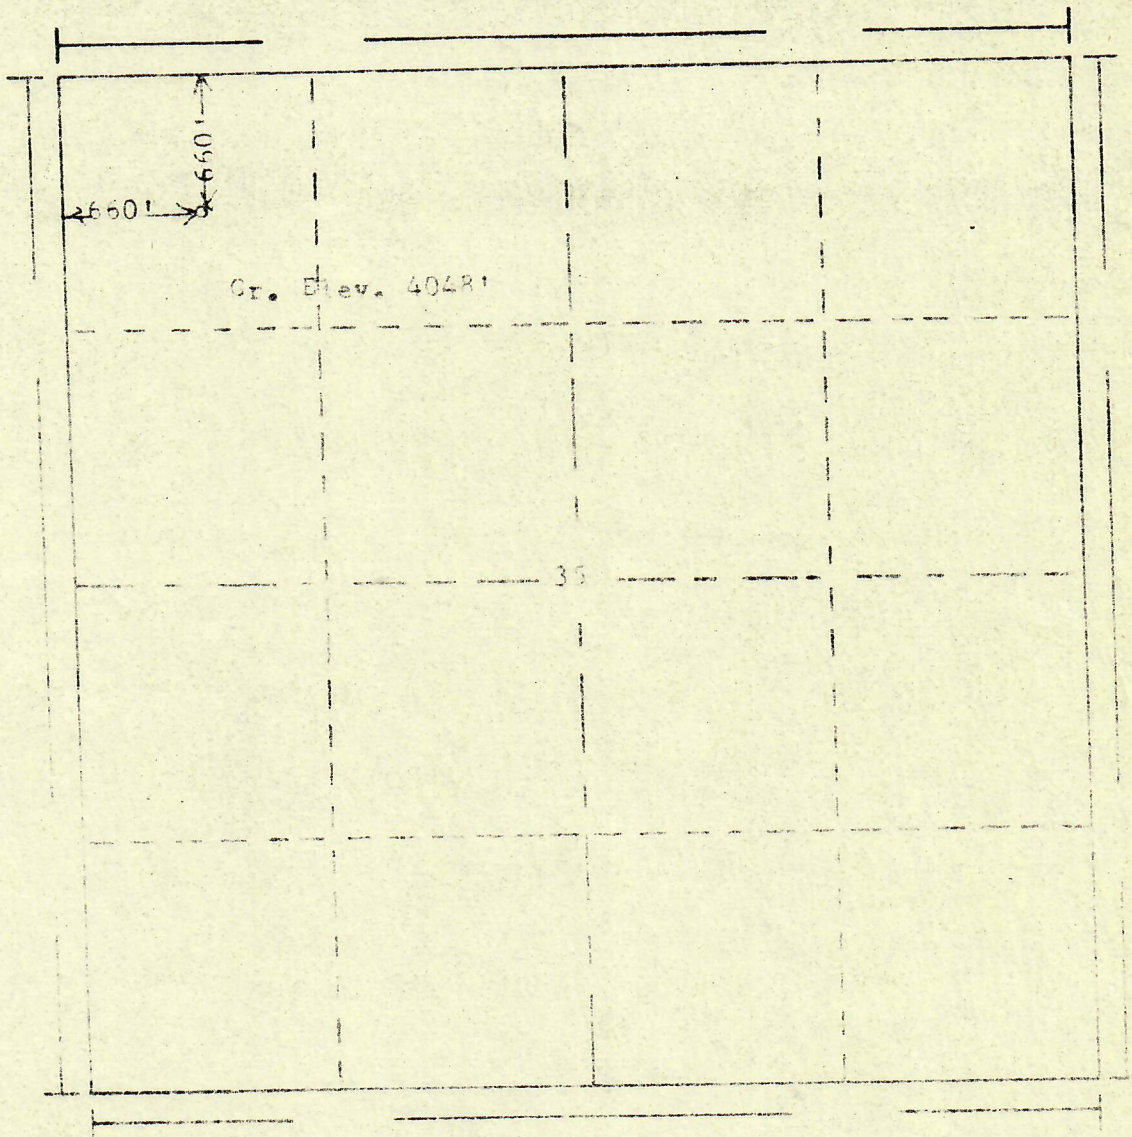

T.  
25  
3

Scale: 1" = 1000'

Powers Elevation Company, Inc. of Denver, Colorado  
has in accordance with a request from Mr. Clarke  
for Michigan-Wisconsin Pipeline Co.  
determined the location of No. **BAILEY 1-35**  
to be 660'EN & 660'EN Section 35 Township  
Range 45N of the 6th Principal Meridian  
Prowers County, Colorado

I hereby certify that this plat is an accurate representation of a correct survey showing the location of

BEST IMAGE  
AVAILABLE

Date: 1-20-75

Licensed Land Surveyor No. 2852  
State of Colorado

75 708