



STATE OF COLORADO
DIVISION OF WATER RESOURCES
OFFICE OF THE STATE ENGINEER
GROUND WATER SECTION

RECEIVED
DEC 30 1963
GROUND WATER SECT.
COLORADO
STATE ENGINEER

RECEIVED

NOV 30 2000

OIL & GAS COMMISSION
WELL LOCATION



Index No. 113
IDWD 2-19
Use Stock
Registered 12-30-63

LOG AND HISTORY OF WELL

PERMIT NO. 18133

Driller M. Snyder Lic. No. 47
Owner C. F. & D. Corp.
Street D. P. Box 316 City Durango, Colo.
Tenant J. W. Macom
Use of Water stock
On or By SW 1/4, SE 1/4, Sec. 34, Twp 34S, Rge 67W
(description of site or land)
Date Started Dec. 3 1963
Date Completed Dec. 7 1963
Yield 10 g. 10 GPM or _____ CFS

WELL DESCRIPTION:

Depth to Water 55 ft. Total Depth 130 ft.
(measured from ground surface)
Hole Diameter { from top ft. to 130 ft., 8 in.
from _____ ft. to _____ ft., _____ in.
from _____ ft. to _____ ft., _____ in.

TEST DATA:

How Tested fail Pump or ✓ Bailed
Date Tested Dec. 7 1963 Length 3 hrs.
Rate 10 GPM Drawn Down 110 from top

PUMP DATA:

Pump Type windmill Outer Size _____ in.
Driven by _____ HP _____

CASING RECORD:


Plain Casing

Size 7 Kind steel from top ft. to 85 ft.
Size 7 Kind steel from 105 ft. to 130 ft.
Size _____ Kind _____ from _____ ft. to _____ ft.

Perforated Casing

Size 7 Kind steel from 85 ft. to 105 ft.
Size _____ Kind _____ from _____ ft. to _____ ft.
Size _____ Kind _____ from _____ ft. to _____ ft.

Las Animas County
SW 1/4 of SE 1/4 of Sect. 34
Twp 34S Rge 67W 6 PM

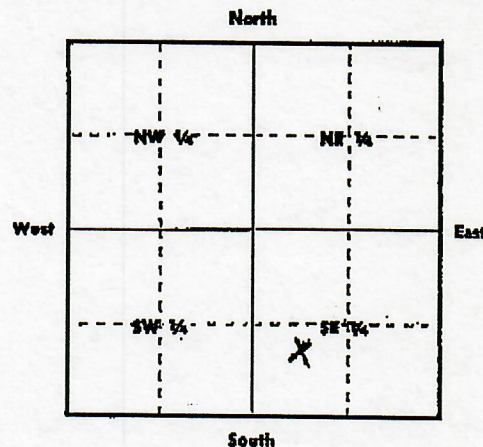

ABOVE DIAGRAM REPRESENTS ONE FULL SECTION. LOCATE WELL ACCURATELY IN SMALL SQUARE REPRESENTING 40 ACRES.

or
If the above is not applicable fill in:
No. _____ Street _____
City or Town _____
or
Lot _____ Block _____
Subdivision _____
(include filing or number)

TO BE MADE OUT IN QUADRUPPLICATE:

Original Blue and Duplicate Green Copy must be filed with the State Engineer within 30 days after well is completed. White copy is for the Owner and Yellow copy for the Driller.