


103-40160

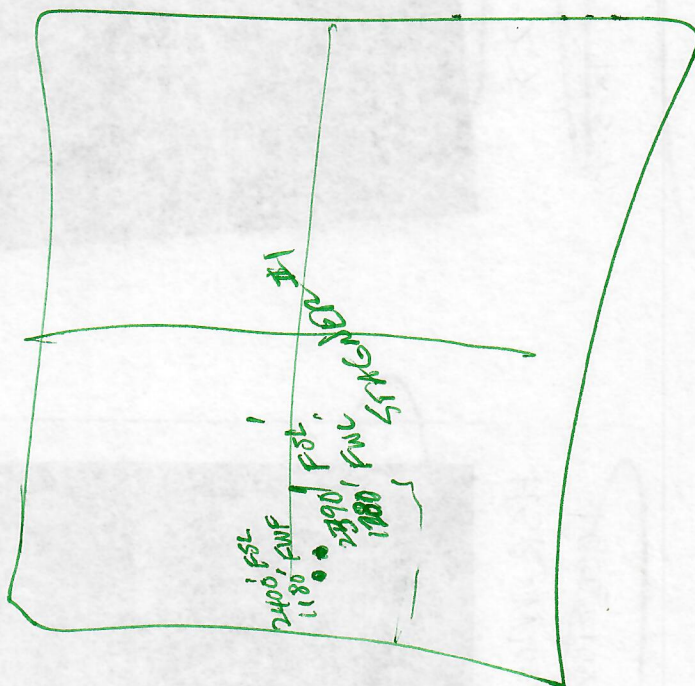

00053124