




R. 50W

RECEIVED
JUL 21 1966
OIL & GAS
CONSERVATION COMMISSION

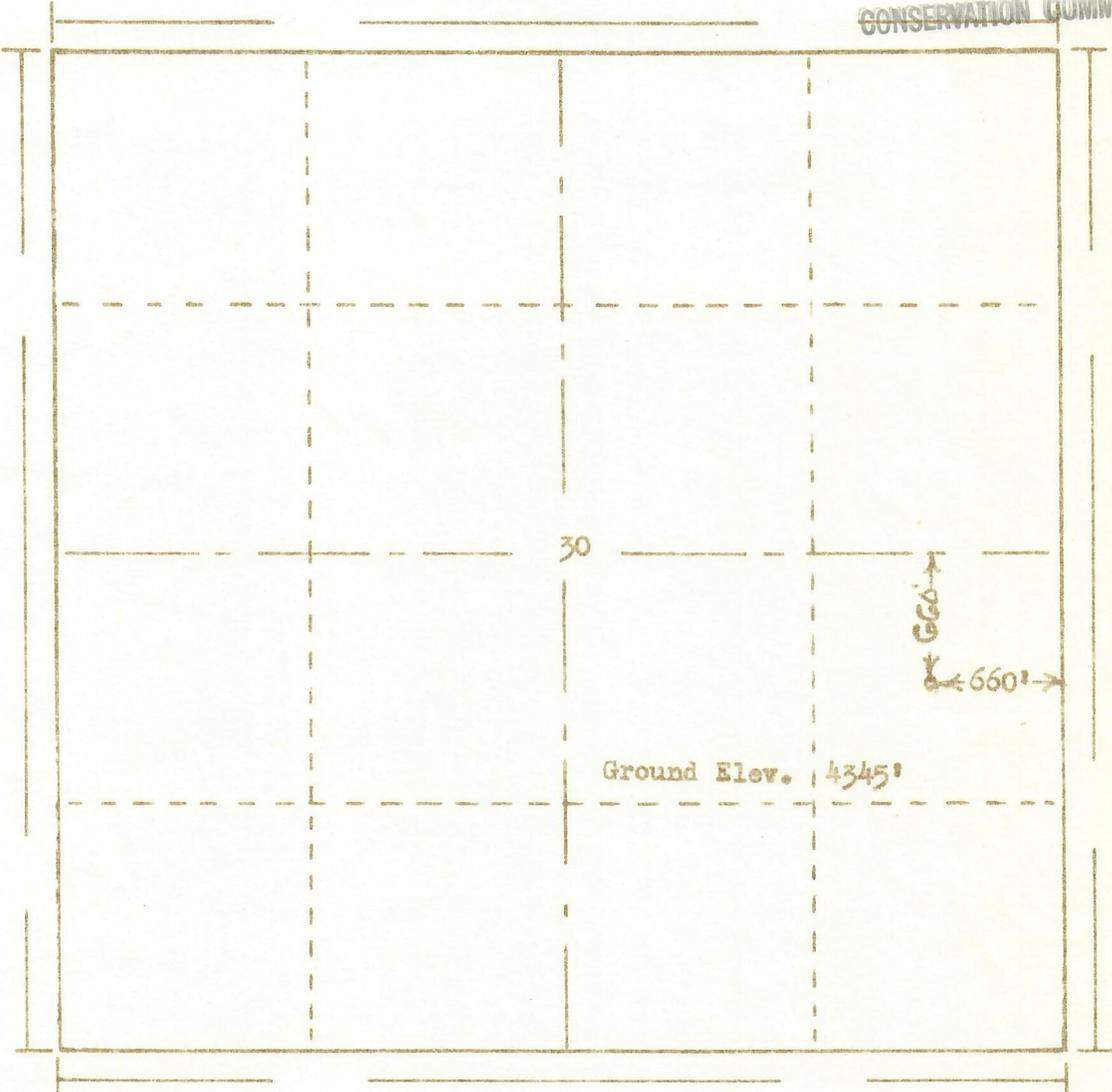

T.
8
N

Scale ... 1" = 1000'

Powers Surveyors, Inc. of Denver, Colorado
has in accordance with a request from Miss Harris
for Sentinel Petroleum Corp. determined the
Location of No. 3 State-Monaghan
to be CNE SE Section 30 Township 8N
Range 50W of the 6th Principal Meridian
Logan County, Colorado

I hereby certify that this plat is an
accurate representation of a correct
survey showing the location of

Date: 7-11-66

Brian J. Holloman
Licensed Land Surveyor No. 18853
State of Colorado