



00251682

RM F-108

BEST COPY AVAILABLE


EXHIBIT "A"
Location & Elevation Plat

RECEIVED

OCT 1 1981

R. 93 W.

COLO. OIL & GAS CONS. COMMI.

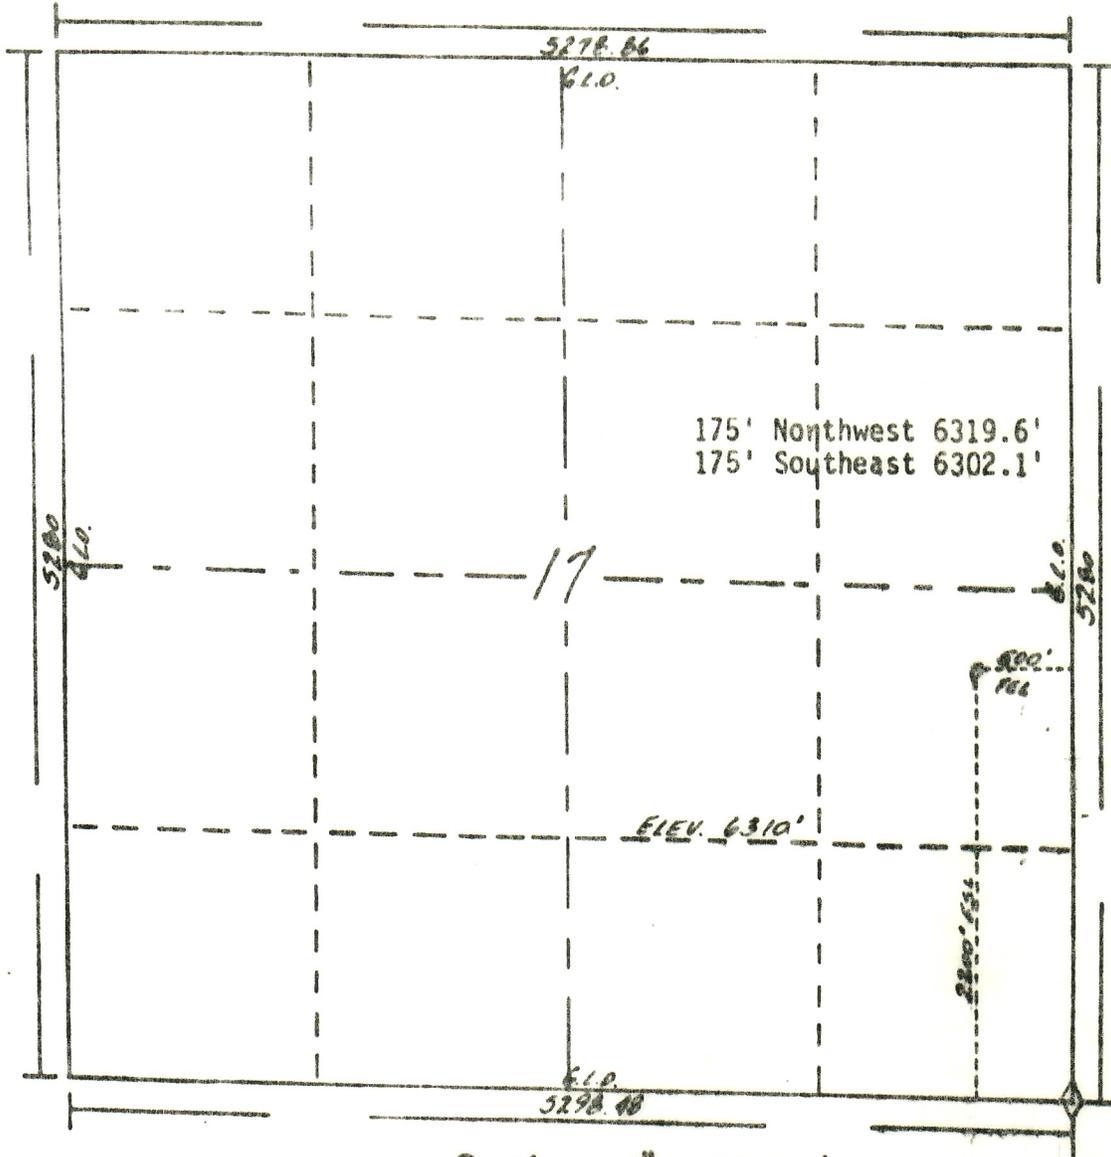

T.
7
N.

Scale... 1" = 1000'

Powers Elevation of Denver, Colorado
 has in accordance with a request from *Ledy Bartlett*
 for *DANSON OIL CORPORATION*
 determined the location of #17-1 BIG GULCH
 to be 2200' FSL & 500' FEL of Section 17 Township 7N.
 Range 93 W. of the 6th Principal Meridian
 Moffat County, Colorado

I hereby certify that this plat is an
 accurate representation of a correct
 survey showing the location of

17-1 BIG GULCH

Date: 9-18-80

James P. Beckel

7