




R. 53 W.

301

N

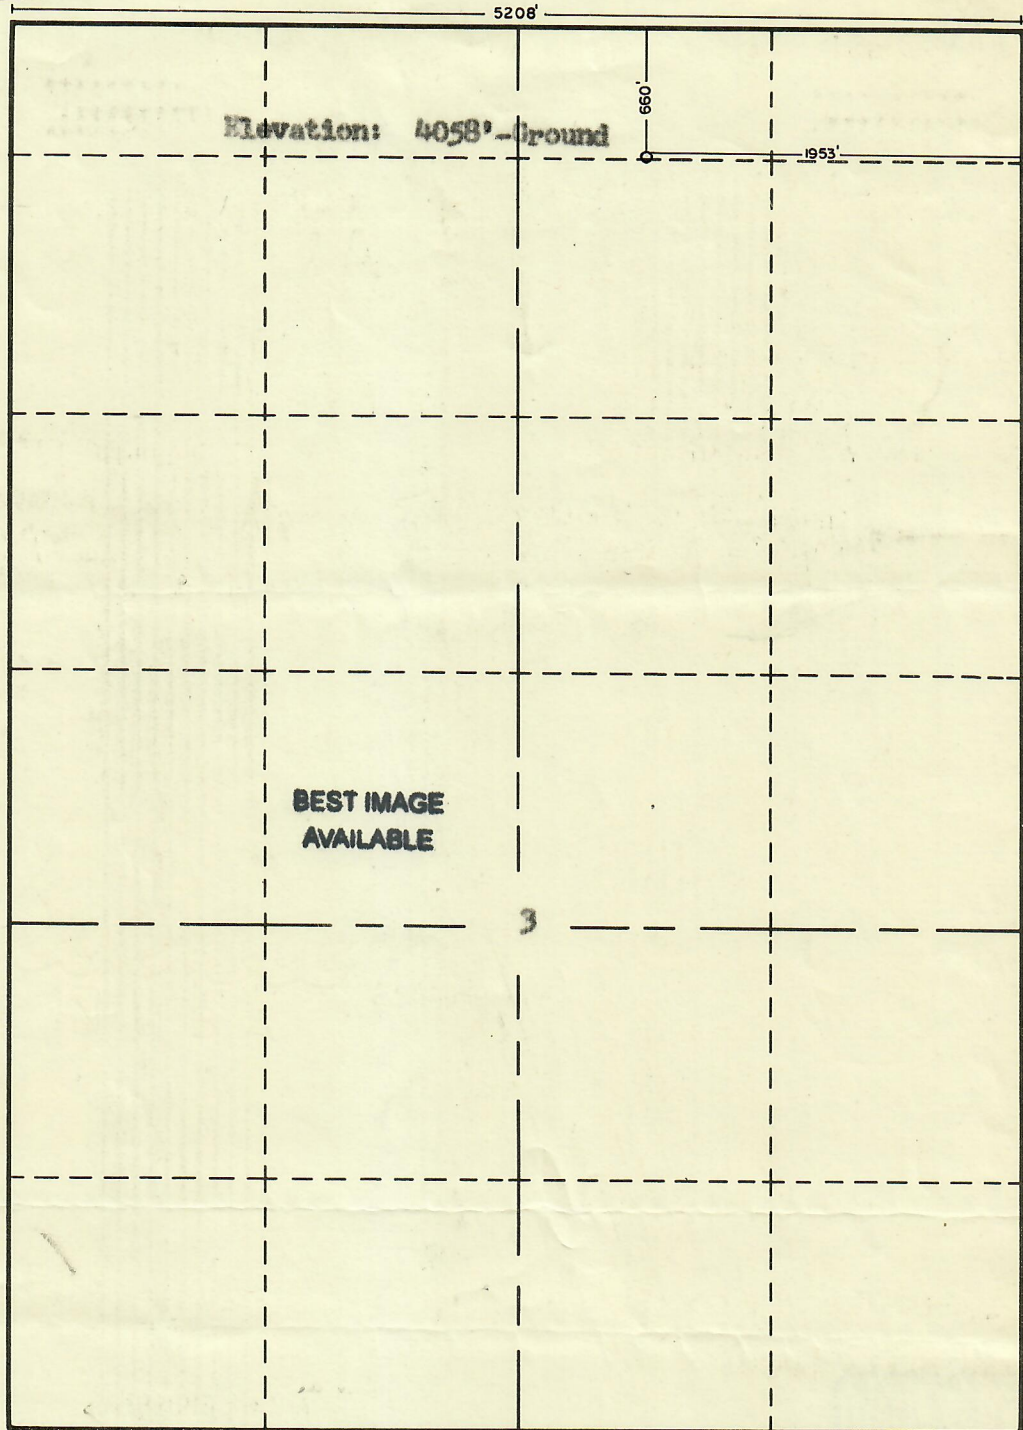

075-06189

T.
8
N.

Scale 1" = 1000'

Powers Elevation Company of Casper, Wyoming has in accordance with a request from **Mr. Rosenberger** for **Trigood Oil Company** determined the location of **#1 Tetzell** to be **660' PM & 1953' PE** Section **3** Township **8** North Range **53** West Logan County, Colorado.

The above plat shows the location of the well site in said section.

Powers Elevation Company

by: *Burr Leibert*

Date: **12-8-54**

