




00210552

# OIL AND GAS CONSERVATION COMMISSION OF THE STATE OF COLORADO

## NOTICE OF INTENTION TO DRILL

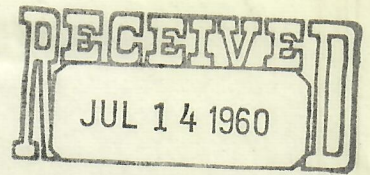

OIL & GAS  
CONSERVATION COMMISSION


### INSTRUCTIONS:

A notice of intention to drill a well shall be filed in duplicate on all Federal and Patented lands, and in triplicate on all State lands. Do not begin operations until approved copy has been received. It is mandatory that the proposed location comply with all rules and regulations of the Commission. Locate well on section grid in proper location, and indicate extent of lease. Unless operations are commenced within 180 days after the date of approval hereof, this approval to drill will become null and void.

Name of Operator Braden Drilling, Inc. Phone No. AM 7-2266  
Address 1206 Union National Bldg. City Wichita State Kansas

How is liability secured: Well Bond (Attached) ☐; Blanket Bond ☒; Waiver ☐  
(Check one)

Lease Name Monahan - *state*  
Well No. 1  
Field Name \_\_\_\_\_ Wildcat ☒  
County Logan

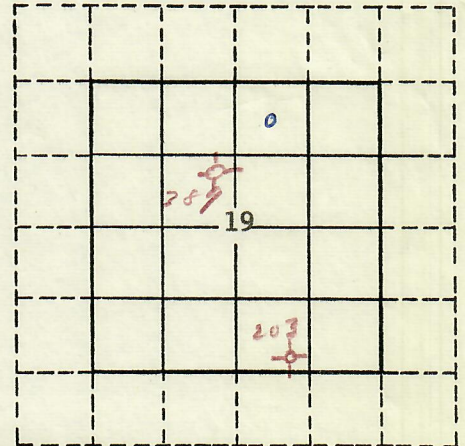

Location C NW 1/4 NE/4 (quarter quarter) Section 19 Township 8N Range 50W Meridian 6<sup>th</sup> PM  
660 feet from N Section line and 1980 feet from E Section Line  
N or S E or W

The well is located on: Patented land ☐ State land ☒ Federal land ☐

The well is located within a spaced area: Yes ☐ No ☐

Distance from proposed location to nearest property or lease line 660 feet.

Distance from proposed location to nearest drilling unit line 660 feet.

Objectives: "D" Sand Depth 4375 ; "J" Depth 4500  
Formation Estimate Formation Estimate

Proposed length of surface casing 300 feet.

REMARKS:

*came in 7/19/60*

Agent	<i>State</i>
Bond	<i>State</i>
Spot	
600 ft.	
1200 ft.	
Wells	
Oil	
Gas	
Status	

I/We hereby swear (or affirm) that the statements herein made are a full and correct report.

APPROVED:

Date July 20 1960

Director

Company Braden Drilling, Inc. Date July 12, 1960  
1206 Union National Bldg.

Address Wichita 2, Kansas Phone No. AM 7-2266

By Jim Cummins Signature Title Sec. Dir.