




M 05 075 9141

VERBAL REQUEST

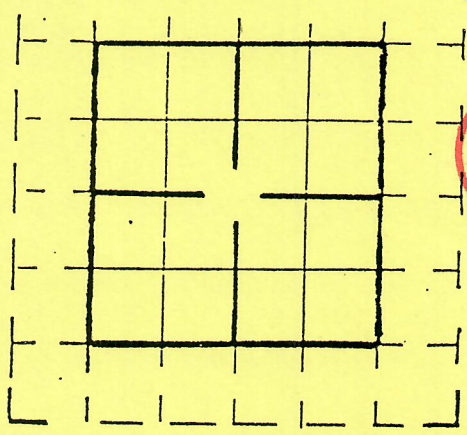

NOTICE OF INTENT TO DRILL _____
NOTICE OF INTENT TO ABANDON ☒
OTHER _____

COMPANY Skaer ADDRESS _____

BY _____ PHONE NO. _____ EXT. _____

WELL NO. 4-1X LEASE Reike

COUNTY Logan FIELD _____ DRLG UNIT _____

LOCATION SWSW SEC 4 TWP 9N RNGE 57W MERIDIAN _____
_____ ft. from N or S Sec. Line, and _____ ft. from E or W Sec. Line

ESTIMATED DATE OF WORK 10/28/90 ESTIMATED TIME _____

DETAILS OF PLAN OF WORK: T.D. 5200 FORMATION _____


SURFACE CASING 8 5/8 @ 135' KB

I-Sand 150' away (new well did not penetrate I-Sand)
Cored I-Sand, small shows-DST heavy mud.
35 SXS 1/2 in - 1/2 out @ 135'
10 SXS @ top, cut and weld 4' below GL

BONDING STATUS: PLUGGING _____ SURFACE _____ OTHER _____

Is surface owner also mineral owner? _____

ACREAGE LEASED SURROUNDING DRILLSITE _____

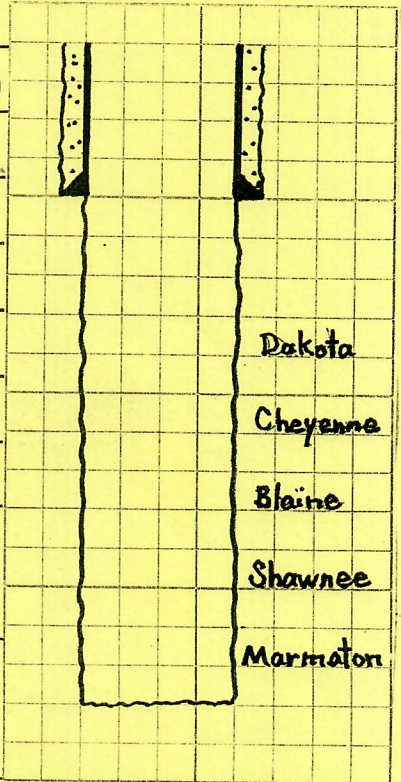

APPROVED BY: S. Pott DATE 10/28/90
10:45 PM