




00247258

Well #13-35
5/120

CNE NW SEC 35

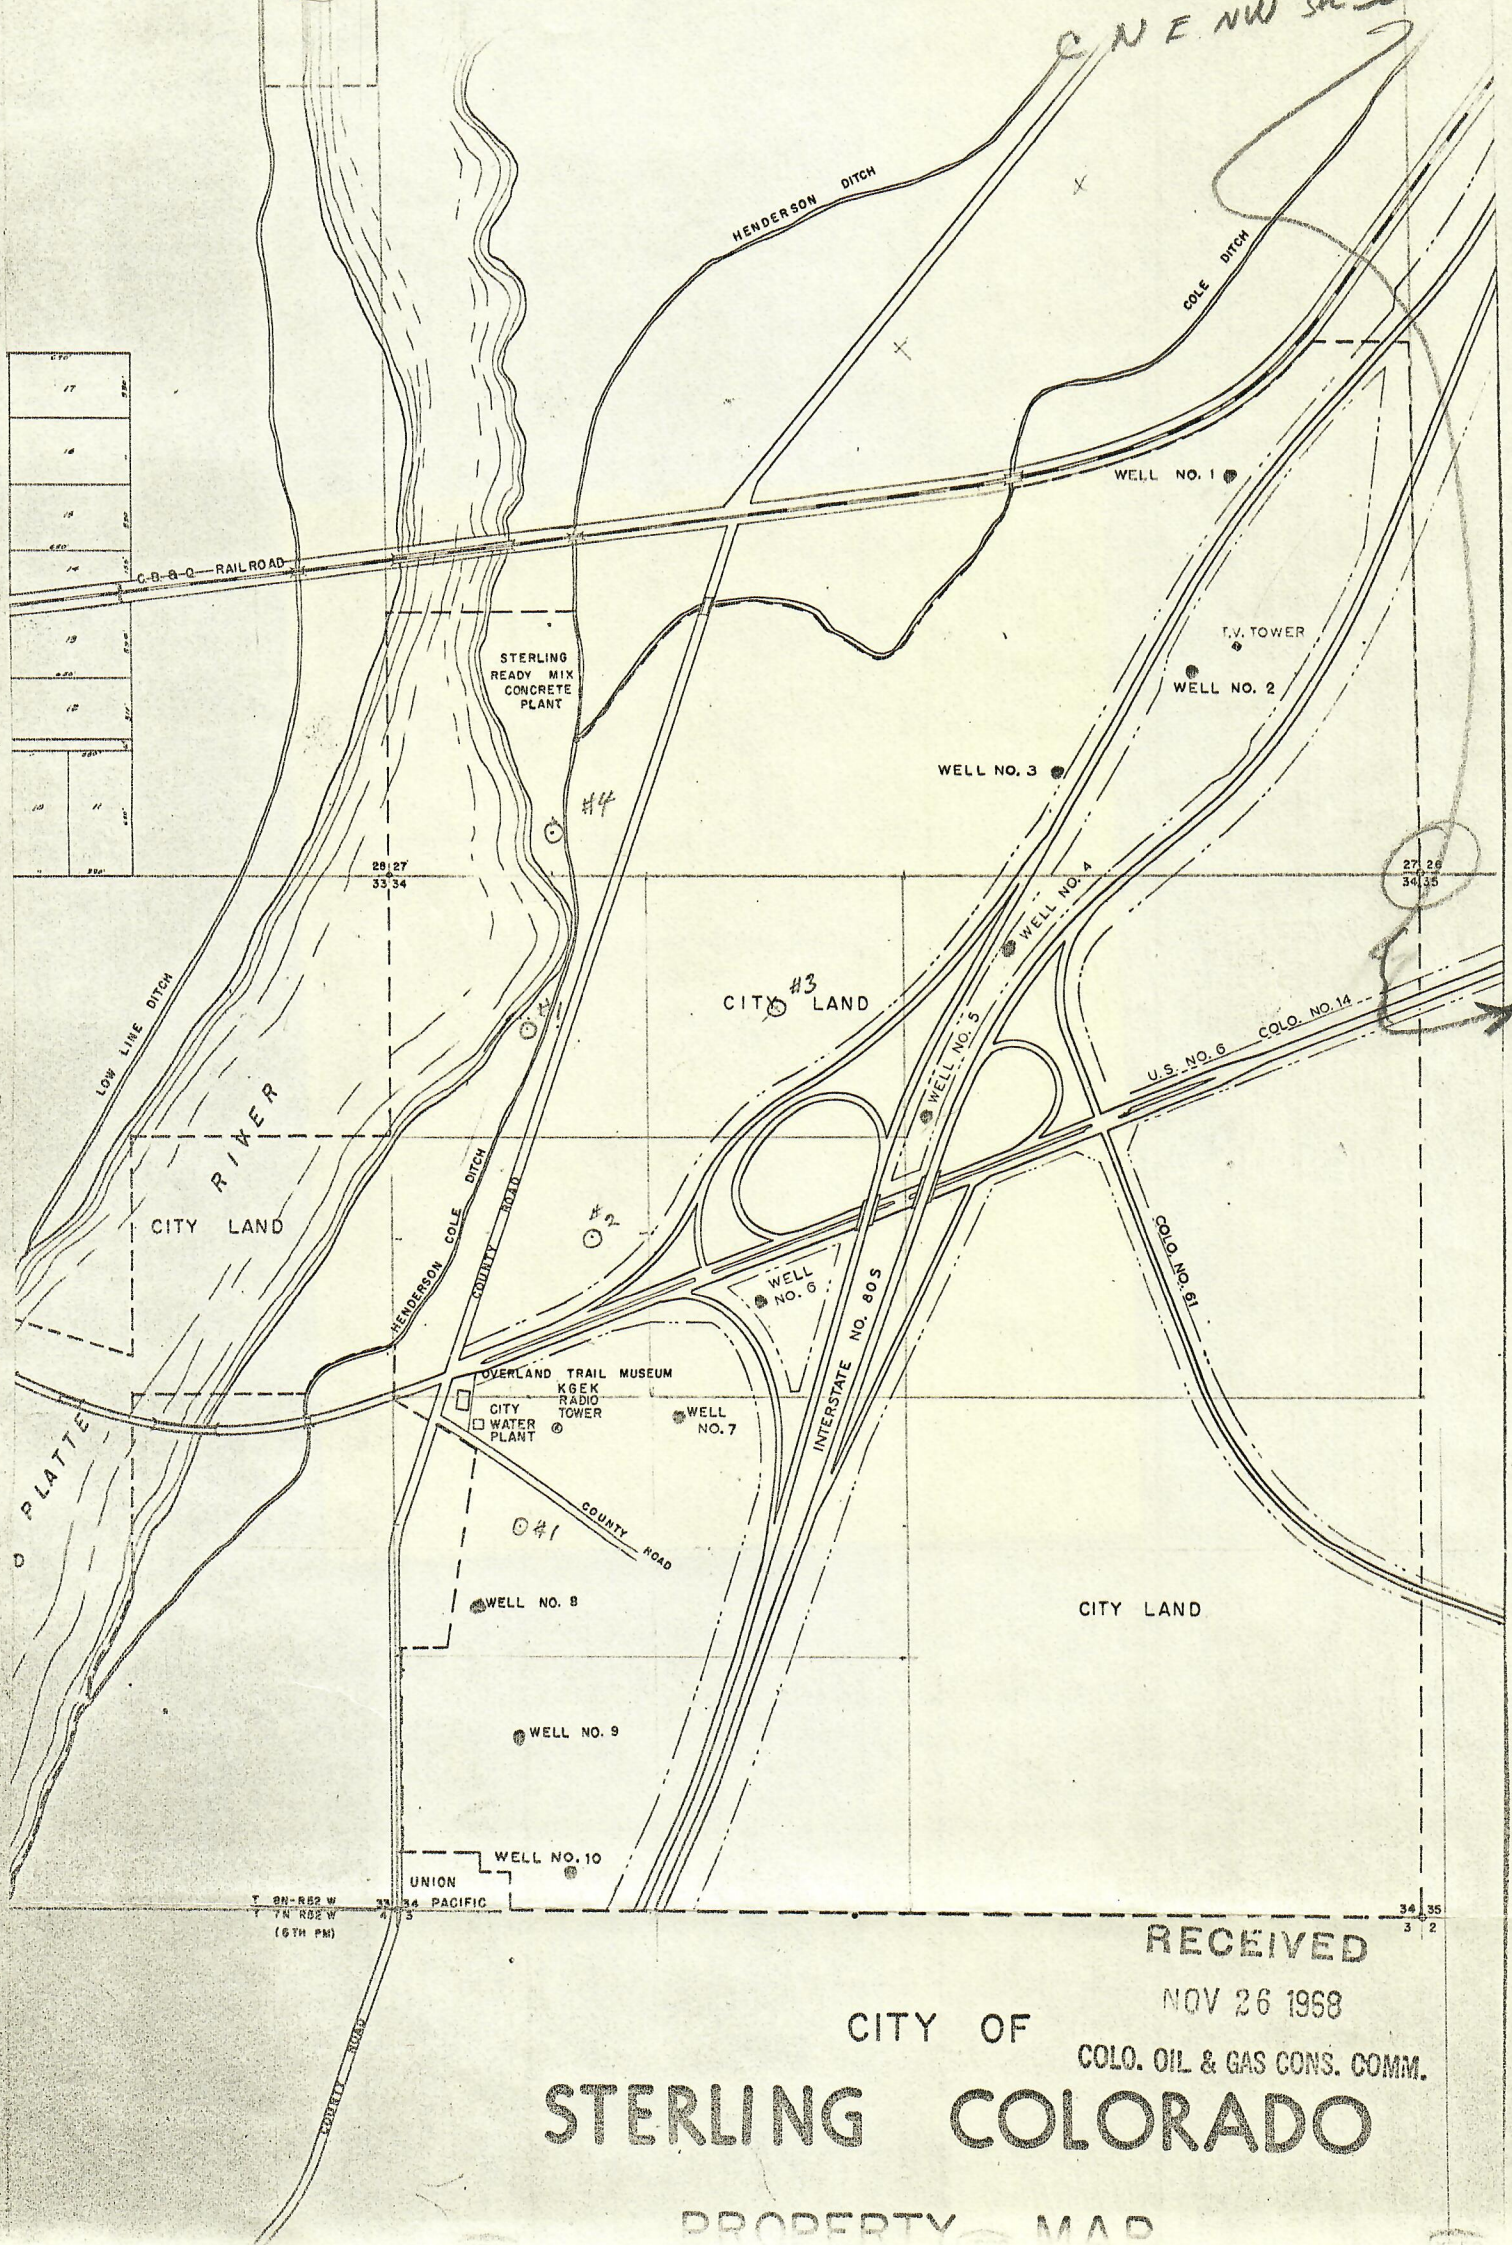

RECEIVED

NOV 26 1968

CITY OF

COLO. OIL & GAS CONS. COMM.

STERLING COLORADO

PROPERTY MAP

Called

2/28/72

Bob Boekel

President of Beaver Mesa

Pipe + Tubing in well

Well either complete or
GPTA probably this summer

He will send in status
report
