


CERTIFICATE OF SURVEY
for
Rex Monahan
Logan County, Colorado



RECEIVED

APR 12 1977

COLO. OIL & GAS CONS. COMM.

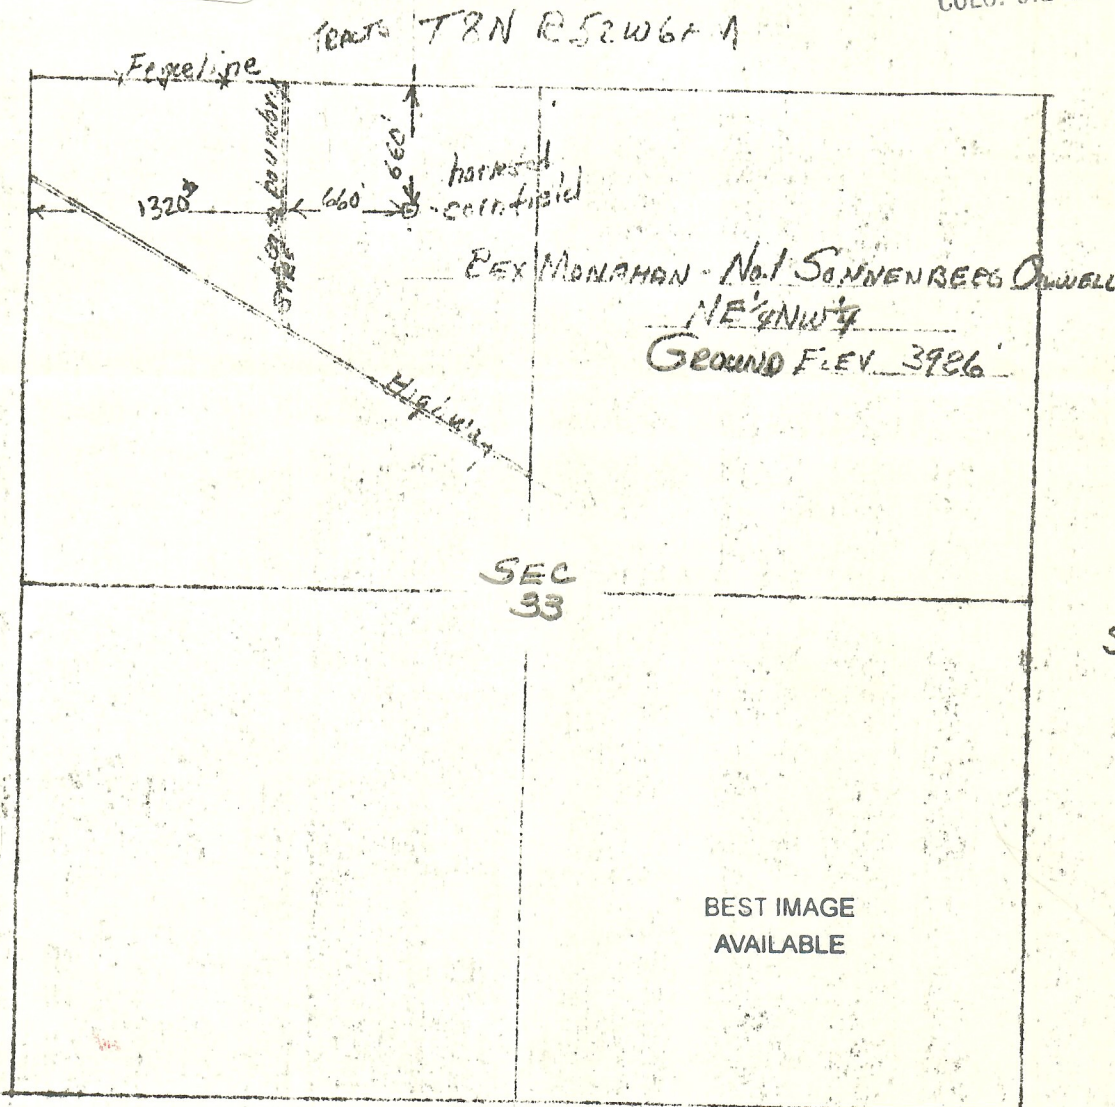

I hereby certify that the above plat is an accurate representation of a correct survey showing the location of Rex Monahan No. 1 Sonnenberg Oilwell in NE 1/4 NW 1/4 Sec. 33 T8N R52W 6PM. The elevation of the ground at the stake is 3926. feet above sea level from U.S.G.S. Bench Mark.

Fort Morgan, Colorado
Oct. 11, 1976

Lucille J. Caborn
Registered Professional Engineer
State of Colorado

At the landowner's urging, we moved the location to 660' S of N line and 112' W of the NW/4. It was still located on the same mineral rights and offset the same mineral rights all of which was under lease to Rex Monahan.