

**Proposed WELLBORE DIAGRAM to run 4.5" Liner**

**UPRR Baughman Farms 1**

Kuenzler & Flora Reserve Corp

SESE, Sec. 1-15S-45W 6PM

**09-21-2019**


API #: 05-017-06051

Cheyenne Cty, CO

12-3/4" 37.5# @ 387'  
(350sx, cemented to surface)

4 1/2" 10.5# Casing @ 4100'  
Cement to surface w 75 sx

5 1/2" 14# Casing @ 5332'  
125sx 50/50 poz

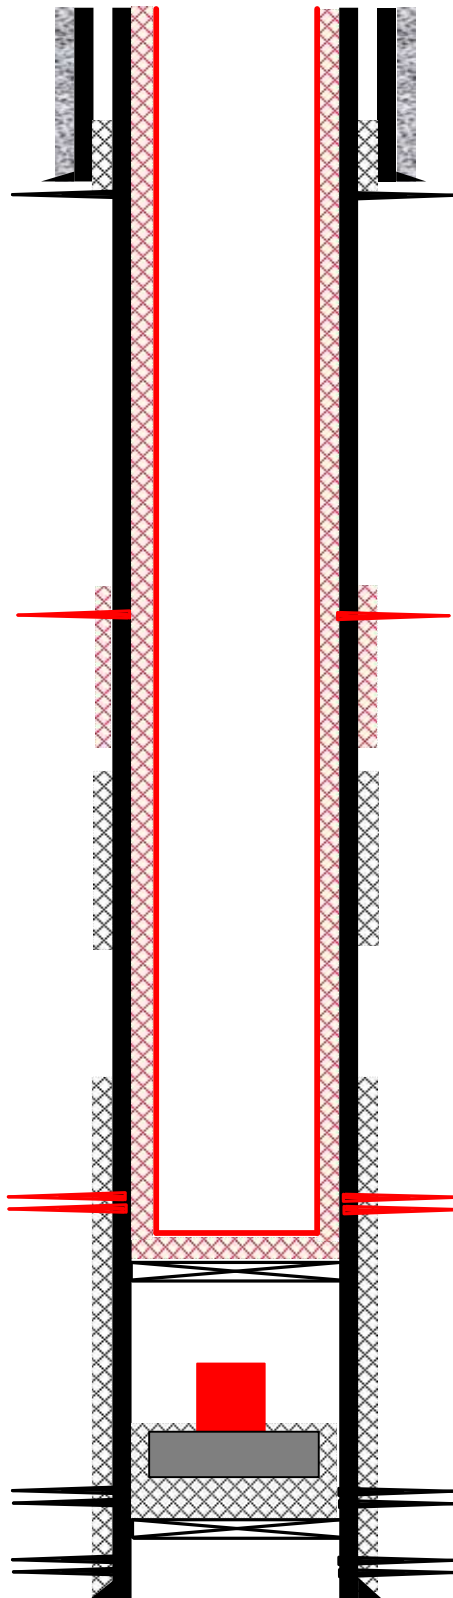

0' - 40'

5 sx

250 - 410'  
410'

40 sx  
squeeze holes

Perf squeeze holes at 1550' (before running liner)

2020' TOC

2350' BOC

3550' TOC

Cement as seen on  
09-10-2019 CBL

4010-50' Shawnee Objective Formation

4100' CIBP set XXXX

4961' Fish: 11 jts 2-7/8" tbg, SN, Packer

Squeezed perms w/ 30 sx on PA

5150 - 5166' perms (St. Louis)

5214' CIBP

5236 - 5266' perms (Spergen)

Drilled by International Nuclear Corp in 1969,  
Plugged & Abandoned by Murfin Drilling Company in 1996