




00816797

R. 53 W.

54 of 60


N

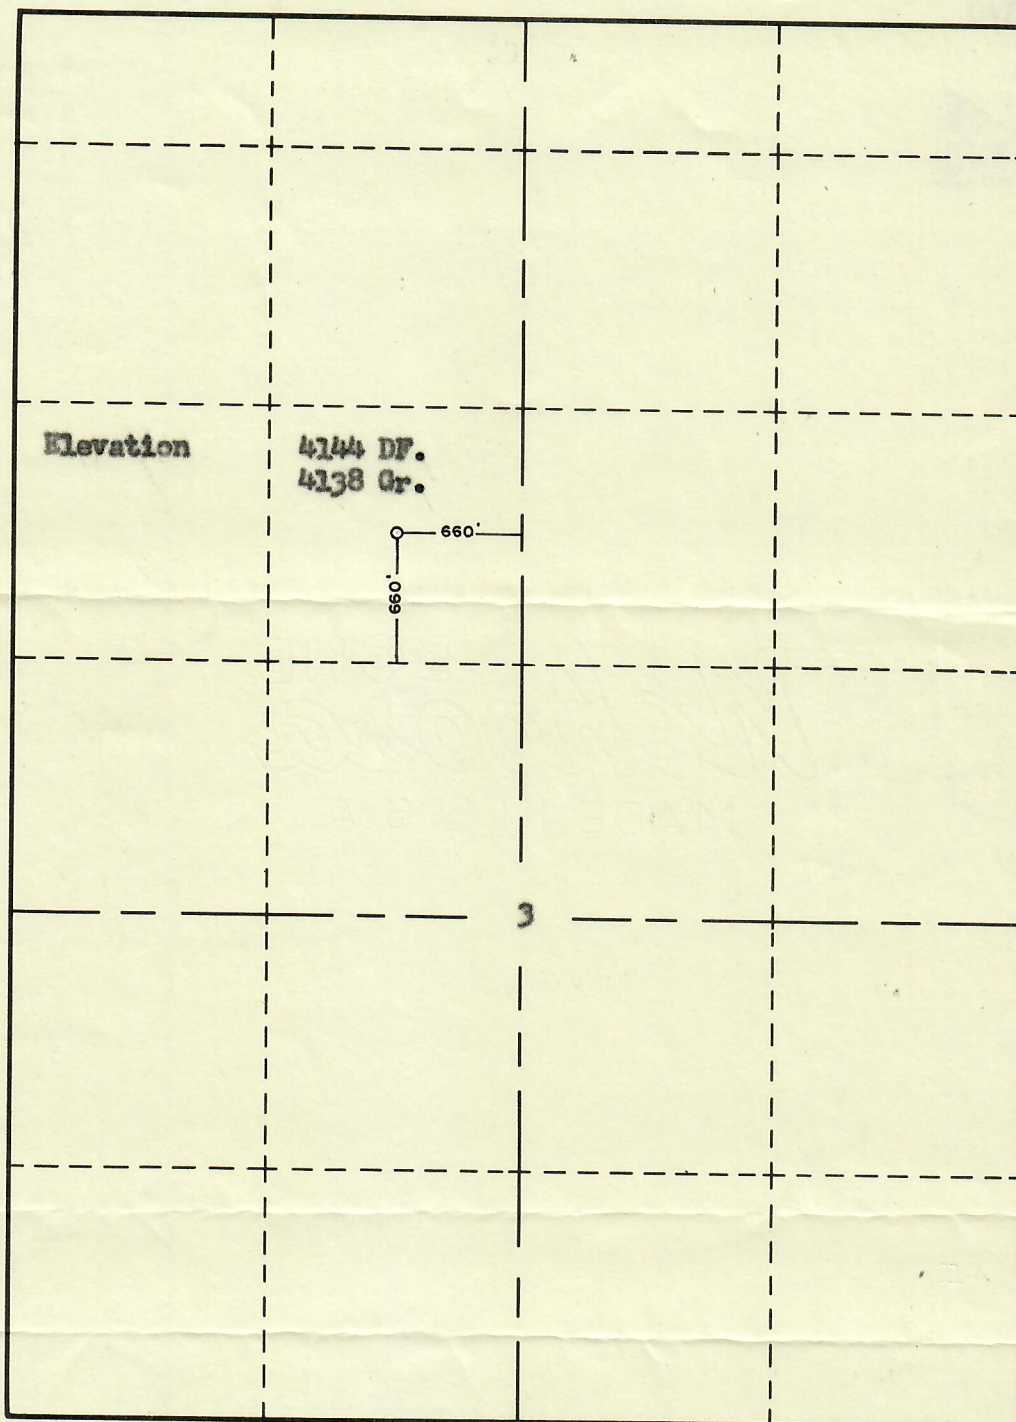T.
8
N.

Scale.....1"=1000'

Powers Elevation Company of Casper, Wyoming has in accordance with a request from **Mr. Wish** for **Trigood Oil Company** determined the location of **#3 Tetsell** to be **660' RS & 660' RE Lot 3** Section **3** Township **8** North Range **53** West Logan County, Colorado.

The above plat shows the location of the well site in said section.

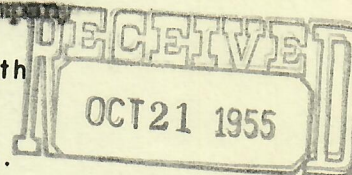

Powers Elevation Company

OIL & GAS
CONSERVATION COMMISSION

by:

Burr Leebek
Registered Land Surveyor

Date: 8-20-55