


CERTIFICATE OF SURVEY
for
A.T.Skaer
Logan County, Colorado

RECEIVED

SEP 12 1968

COLO. OIL & GAS CONS. COMM.

T9N R53W 6PM
5336 & ROAD

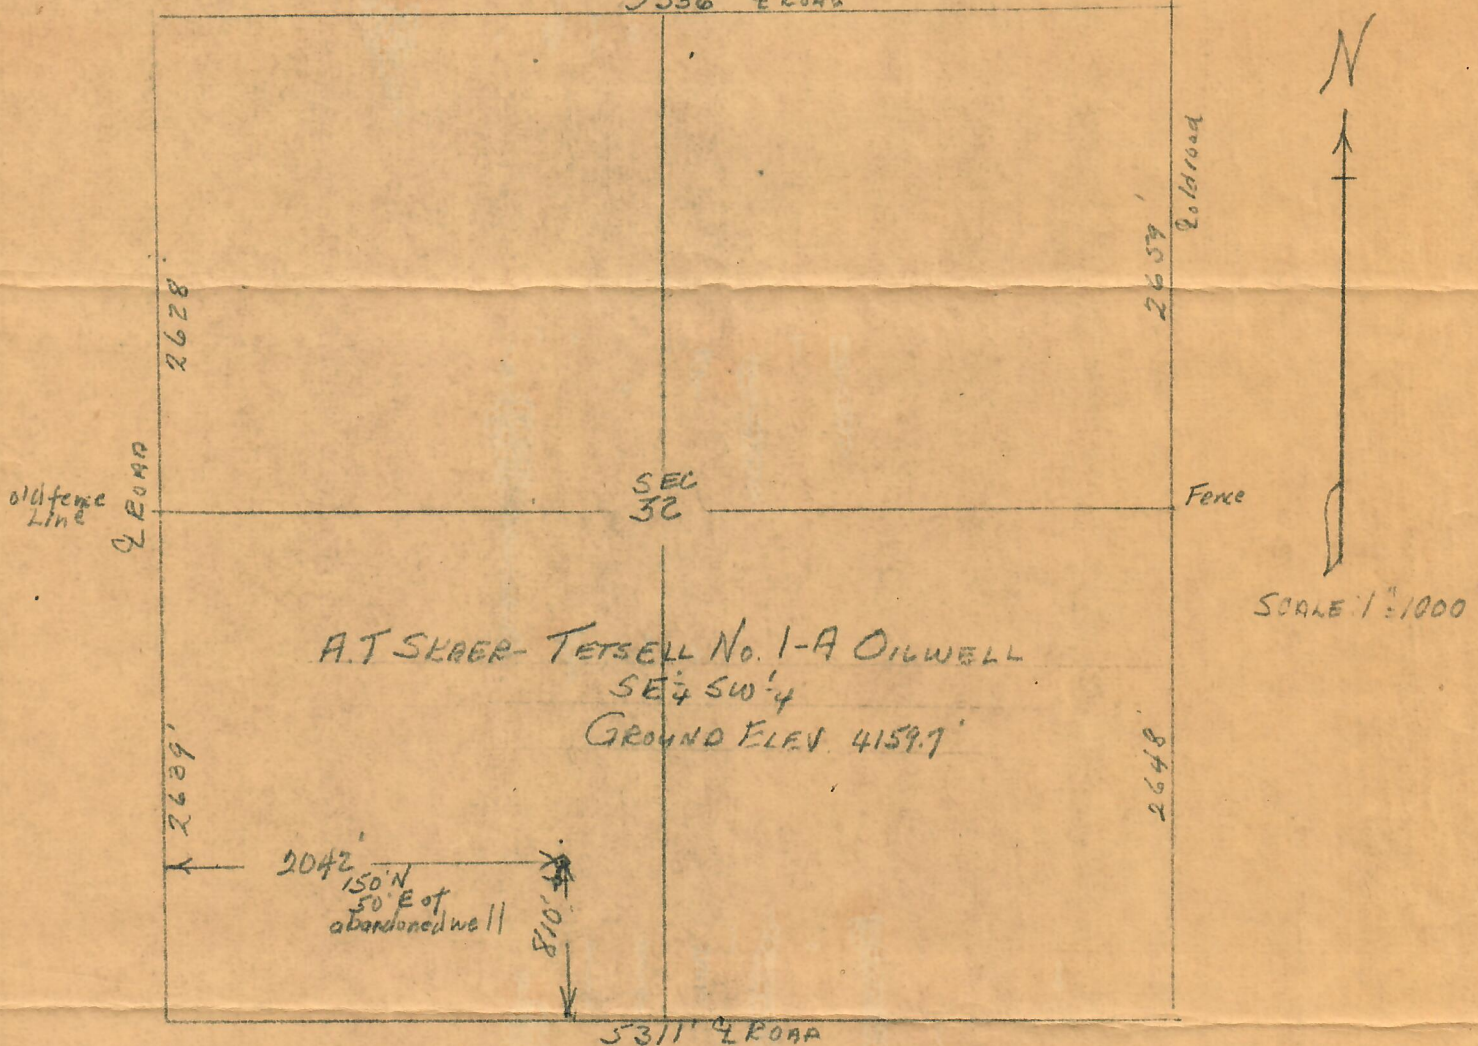

I hereby certify that the above plat is an accurate representation of a correct survey showing the location of A.T.Skaer-Tetsell No.1-A Oilwell 150 north and 50 feet east of center SE 1/4 SW 1/4 Sec.32 T9N R53W 6PM. The elevation of the ground at the stake is 4159.7 feet above sea level from U.S.G.S. Bench Mark.

Fort Morgan, Colorado
Sept.8, 1968

Cecil J. Osborne
Registered Professional Engineer
State of Colorado

68 345

