



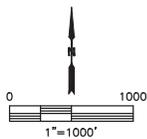

# WELL LOCATION CERTIFICATE

EMMY STATE H36-753

SECTION: 25  
TOWNSHIP: 3N  
RANGE: 65W  
6TH. P.M.  
WELD COUNTY, CO

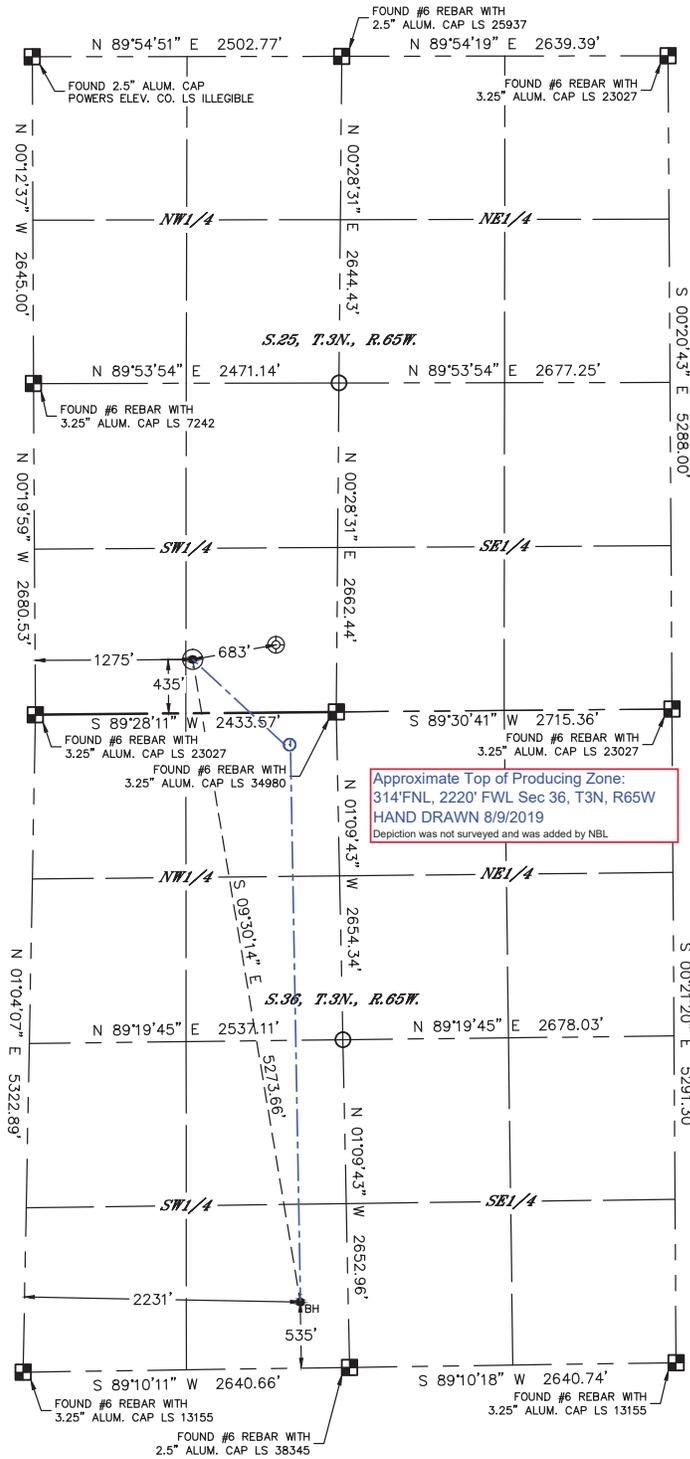

CLIENT: NOBLE ENERGY, INC.			LANDMAN: TYLER BEAVERS		
INSTRUMENT OPERATOR: SCOTT SHERARD			SURVEY DATE: 4/3/2017		
SURFACE USE: RANGELAND					
SHL FOOTAGE	SHL LAT °	SHL LONG °	SHL PDOP	SHL ELEV (FT.)	SHL S-T-R
435   FSL   1275   FWL	40.19009	-104.61667	1.6	4816	SESW   25-3-65

BHL FOOTAGE	BHL LAT °	BHL LONG °	BHL S-T-R
535   FSL   2231   FWL	40.17579	-104.61374	36-3-65

- LEGEND
- = ALIQUOT MONUMENT AS DESCRIBED
  - = CALCULATED POSITION
  - = SURFACE HOLE LOCATION (SHL)
  - ▲ = ENTRY POINT LOCATION (EP)
  - ⊙ = BOTTOM HOLE LOCATION (BHL)
  - ⊕ = EXISTING WELL
  - ⊗ = ABANDONED WELL

NOTE:

- Bearings shown are Grid Bearings of the Colorado State Plane Coordinate System, North Zone, North American Datum 1983. The lineal dimensions as contained herein are based upon the "U.S. Survey Foot."
- Distances to section lines measured at 90 degrees from said section lines.
- Ground elevations are based on an observed GPS elevation (NAVD 1988 DATUM).
- Latitude and Longitude shown are (NAD 83 DATUM).
- IMPROVEMENTS: See LOCATION DRAWING for all visible improvements within 500' of oil and gas location.
- This map does not represent a boundary survey.

