



00300377


CERTIFICATE OF SURVEY
for
Amarillo Oil Co.
Logan County, Colorado

RECEIVED

JUN 19 1970

COLO. OIL & GAS CONS. COMM.

T12N R52W 6PM

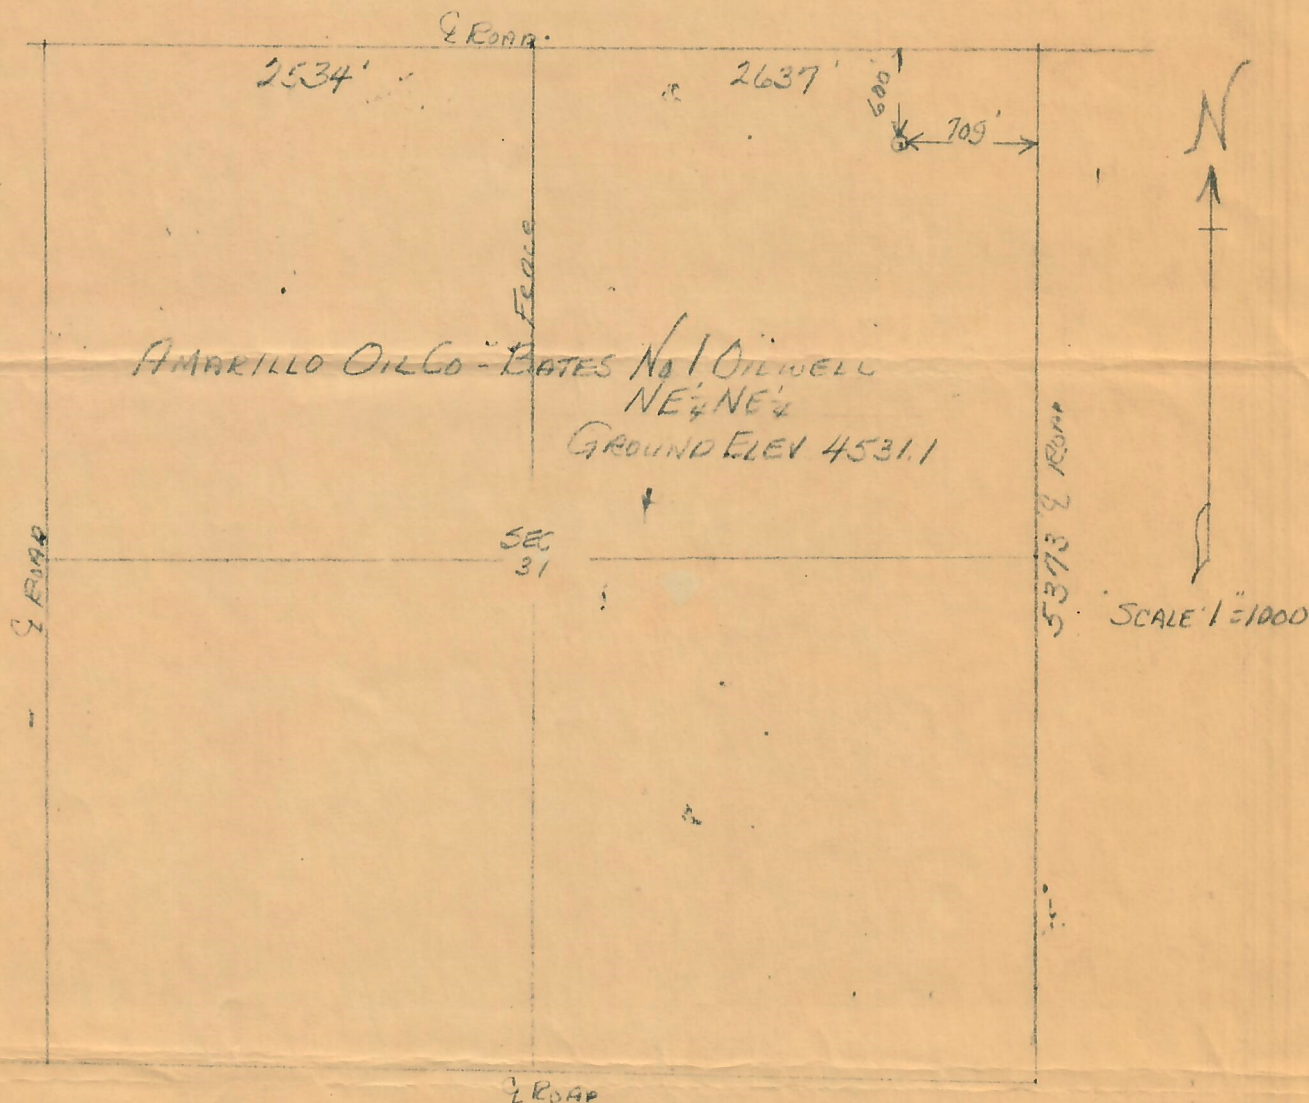

I hereby certify that the above plat is an accurate representation of a correct survey showing the location of Amarillo Oil Co. - Bates No. 1 Oilwell in NE 1/4 NE 1/4 Sec. 31 T12N R52W 6PM. The elevation of the ground at the stake is 4531.1 feet above sea level from U.S.G.S. Bench Mark.

Fort Morgan, Colorado
June 5, 1970

Basil J. Osborne
Registered Professional Engineer
State of Colorado