



00268528

WELL SITE INSPECTION

OPERATOR

Andrew

WELL NAME

Owl Creek #36

RIG

Exeter 33

PERMIT NO

841683

DATE

Nov 20 1988

COUNTY

Weld

LEGAL

NE NE S 35 T 1 N R 6 SW

SURFACE CASING

SIZE

8 5/8

DEPTH

739

DATE

CEMENT VOLUME

400 sks

RETURNS

✓

WOC

PROBABLE FOX HILLS DEPTH

MUD PITS

DISPOSAL

PRODUCTION STRING

✓

SIZE

4 1/2

DEPTH

7371

STAGED

240 sks

CBL CHECKED

SQUEEZE

FRAC JOB

BATTERY

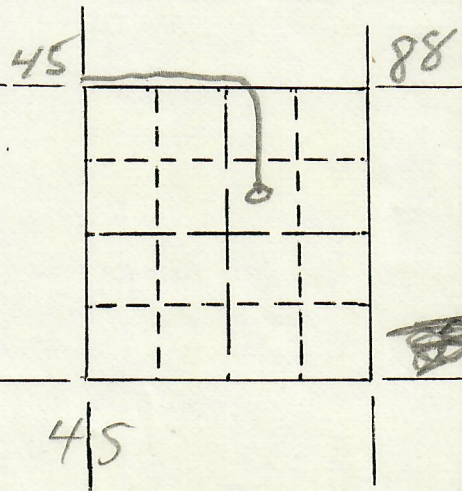
SIGN

SITE INSPECTION AFTER DRILLING

DIRECTIONS

ACTION

ENGINEER

D R Becknell

36-7371-4 1/2

240 shs

Mike Hammett - TP

EX 33 11/13/84

1785

