



00241322


CERTIFICATE OF SURVEY
for
A. F. Skaer
Logan County, Colorado

RECEIVED

MAR 25 1969

COLO. OIL & GAS CONS. COMM.

T9N R53W 6PM

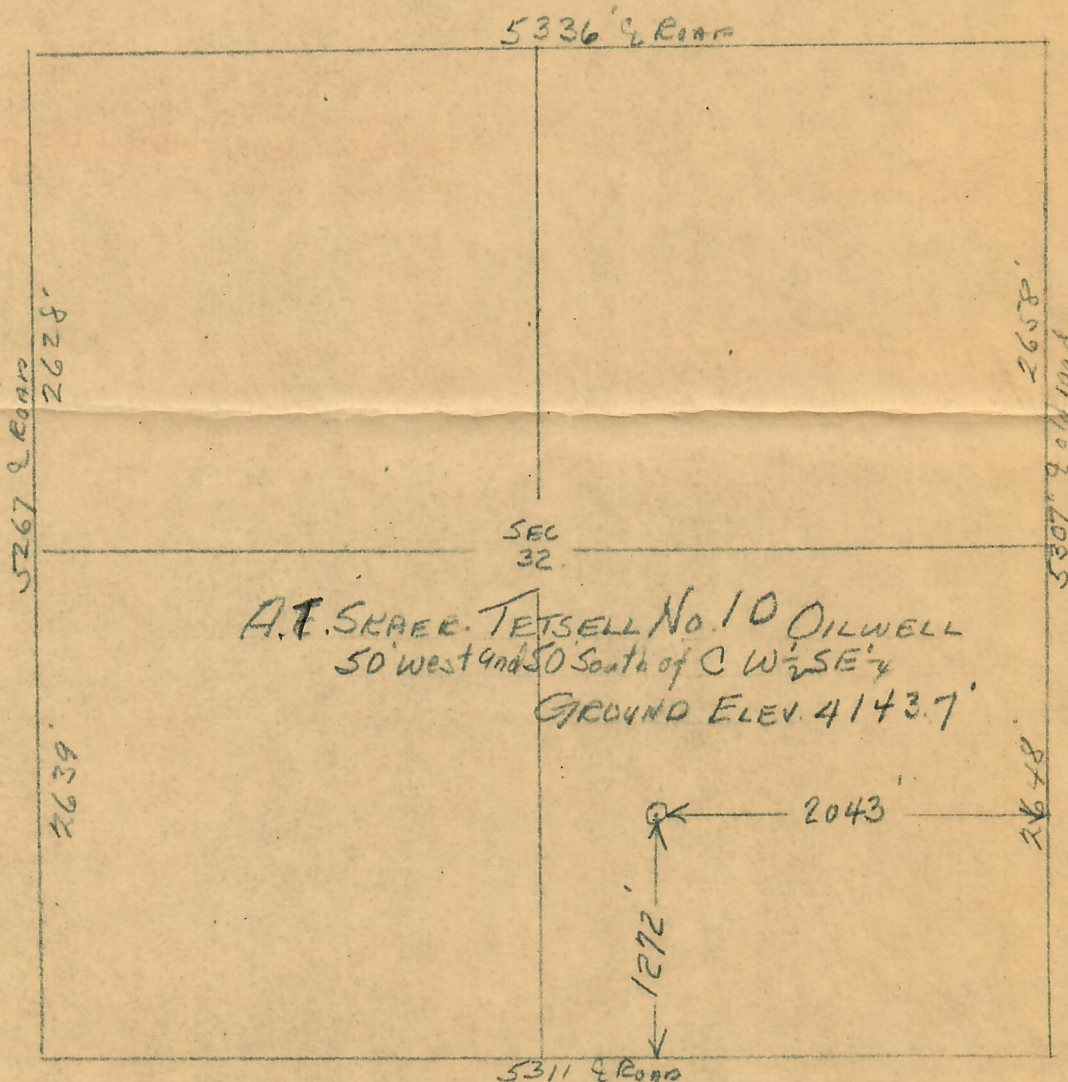

SCALE 1"=1000

I hereby certify that the above plat is an accurate representation of a correct survey showing the location of A. F. Skaer-Tetsel D No. 1 Oilwell 50 feet south and 50 feet west of C W 1/2 SE 1/4 Sec. 32 T9N R53W 6PM. The elevation of the ground at the stake is 4143.7 feet above sea level from U.S.G.S. Bench Mark.

Fort Morgan, Colorado
Jan. 9, 1969

Cecil J. Osborne
Registered Professional Engineer
State of Colorado