



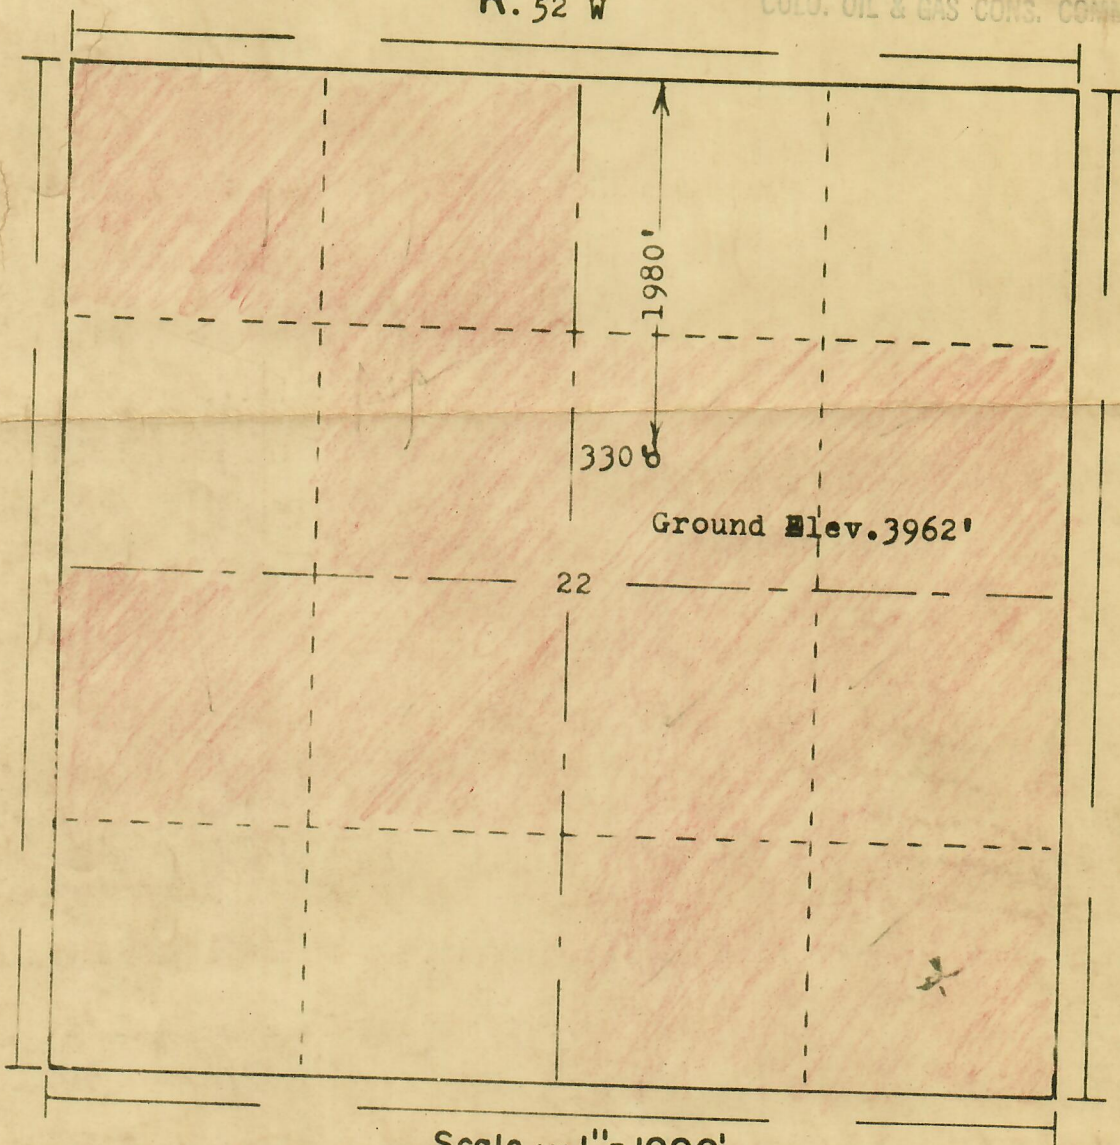
00818083

RECEIVED

DEC 28 1966

COLO. OIL &amp; GAS CONS. COMM.

R. 52 W

T.  
9  
N

Scale ... 1" = 1000'

Powers Surveyors, Inc. of Denver, Colorado  
has in accordance with a request from Mr. Gear  
for Donald C. Winslow & Braden-Gear Drlg. determined the  
Location of No. 1 Giacomini  
to be C W 1/2 SW NE Section 22 Township 9 North  
Range 52 West of the 6th Principal Meridian  
Logan County, Colorado

66 535

66 535

I hereby certify that this plat is an  
accurate representation of a correct  
survey showing the location of

Date: 12-13-66

*Barry D. H. [Signature]*  
Licensed Land Surveyor No. 2853  
State of Colorado