




RECEIVED

JUN 18 1970

COLO. OIL & GAS CONS. COMM.

R. 52W

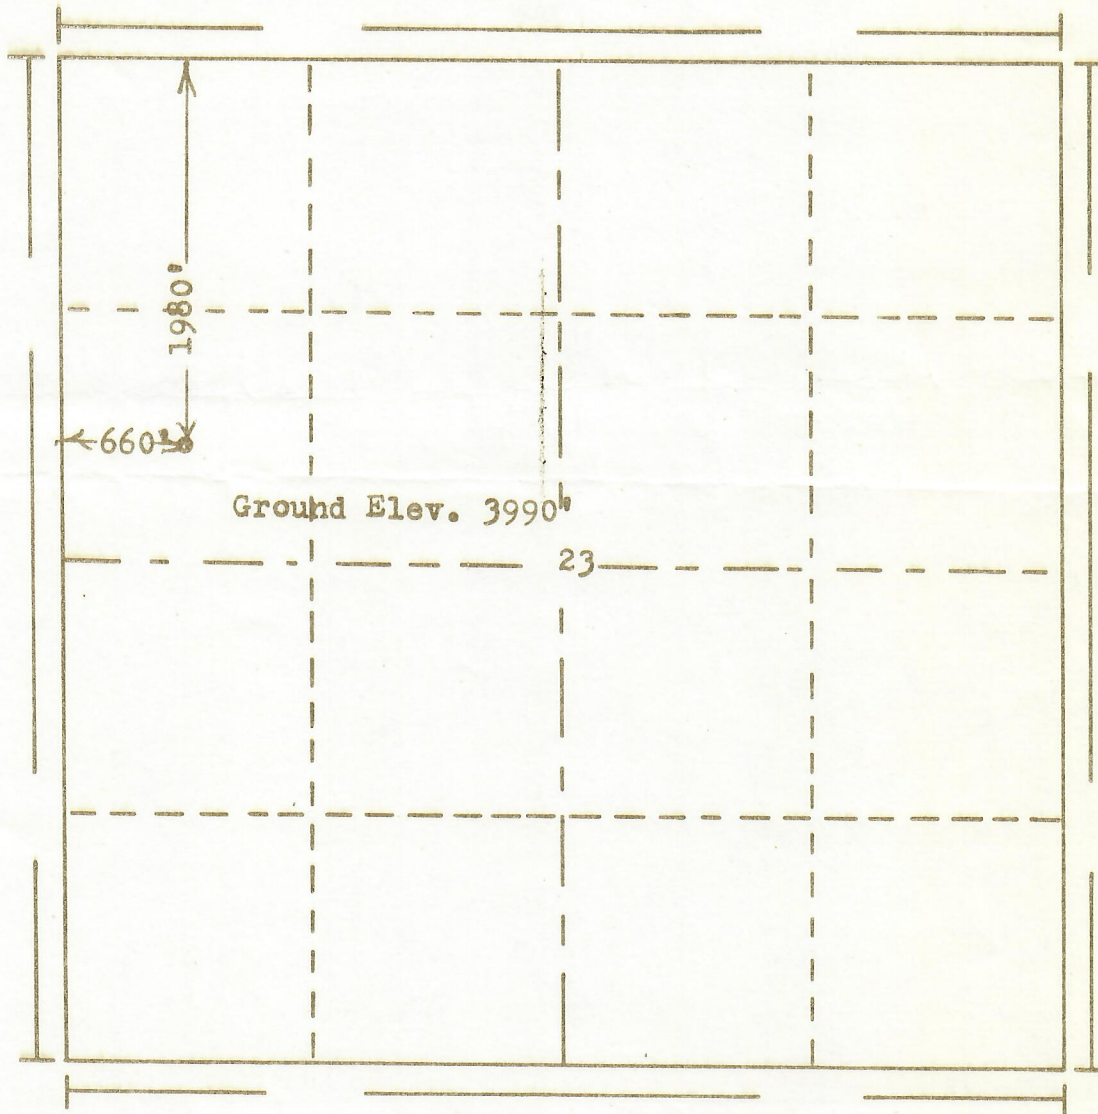

Scale... 1" = 1000'

Powers Elevation Company, Inc. of Denver, Colorado
has in accordance with a request from Mary Abel
for Exeter Drlg. Co. & Chancellor Exploration Co.
determined the location of No. ~~7~~ *Riverhead State #1*
to be CSW NW Section 23 Township 9N
Range 52W of the 6th Principal Meridian
Logan County, Colorado

I hereby certify that this plat is an
accurate representation of a correct
survey showing the location of

Date. 6-2-70

Bing H. Hallway
Licensed Land Surveyor No. 2853
State of Colorado