


Well Name: BB DRAW H04-11J1

VERTICAL, ORIGINAL HOLE, 10/21/2019 3:16:41 PM

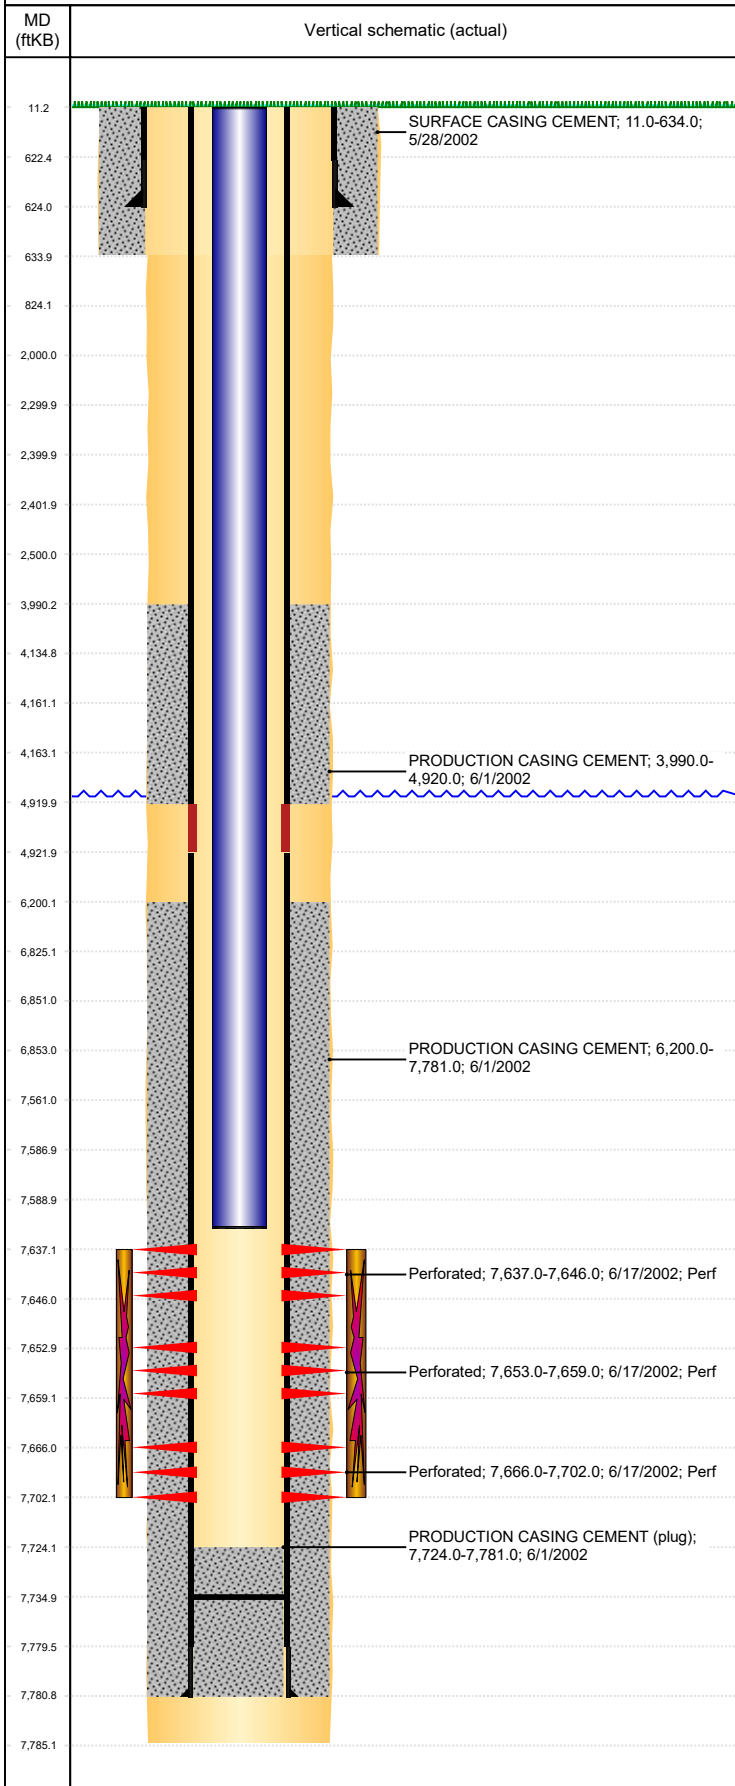

Well Header									
API 05-123-20943		Business Unit DJ BASIN			District 15		Well Config VERTICAL		
KB - GL / MSL (ft... 11.00		Spud Date 5/28/2002		P & A Date		Well Production Status PR			SoRT No
Comment DV TOOL @ +/- 4920'. DRILLED OUT 6/14/2002 PROD CASING SET DEPTH ESTIMATED DUE TO CONFLICTING INFORMATION IN WELL FILE									
Surface Location (Congressional)									
Qtr 3 NE	Qtr 4 SW	Section 4	Twnshp 3	Twnsh... N	Range 65	Rng E/... W	Actual Latitude (°) 40.25288016	Actual Longitude (°) -104.67055444	
Wellbore Sections									
Section Des		Size (in)			Act Top, MD (ftKB)		Act Btm, MD (ftKB)		
SURFACE		12 1/4			11		634		
PRODUCTION		7 7/8			634		7,785		
Casing Strings									
Csg Des		Run Date		OD (in)	Wt/Len (lb/ft)	Grade	Top, MD (ftKB)	MD (ftKB)	
Surface		5/28/2002		8 5/8	24.00		11.0	624.0	
Production		6/2/2002		4 1/2	11.60	N-80	11.0	7,781.0	
Cement									
Des				Start Date		Top (ftKB)		Btm (ftKB)	
SURFACE CASING CEMENT				5/28/2002		11.0		634.0	
PRODUCTION CASING CEMENT				6/1/2002		3,990.0		4,920.0	
PRODUCTION CASING CEMENT				6/1/2002		6,200.0		7,781.0	
Zone Statuses									
Zone Name		Status Date	Status	Fluid Type	Job			Prod Method	
J SAND		8/31/2010	PR	Water				Flowing	
J SAND		11/2/2016	PR						
Perforation Data									
Linked Zone		Bnch/Stg	Entered Shot Total	Top (ftKB)		Btm (ftKB)		Date	
J SAND, ORIGINAL HOLE			18	7,637.00		7,646.00		6/17/2002	
J SAND, ORIGINAL HOLE			12	7,653.00		7,659.00		6/17/2002	
J SAND, ORIGINAL HOLE			72	7,666.00		7,702.00		6/17/2002	
Stimulation Intervals									
Zone				Start Date		Top (ftKB)		Btm (ftKB)	
J SAND, ORIGINAL HOLE				6/21/2002		7,637.0		7,702.0	
Other In Hole									
Run Date		Des			OD (in)	Top (ftKB)		Btm (ftKB)	
Logs									
Date		Type				Top, MD (ftKB)		Btm, MD (ftKB)	
6/2/2002		COMPENSATED DENSITY				4,000.0		7,793.0	
6/2/2002		INDUCTION				624.0		7,793.0	
6/14/2002		CBL/CCL/GR				3,850.0		7,721.0	
Plug Back Total Depths									
Date		Type		Com				Depth (ftKB)	
6/14/2002		CEMENT PLUG		RIH W/BAILER TWO DIFFERENT DAYS HITTING VERY HARD...				7,724.0	
4/5/2012		FILL						7,735.0	