



RECEIVED

JUN 4 1968



COLO. OIL & GAS CONS. COMM.

RECEIVED

MAY 27 1968

R. 47W

N

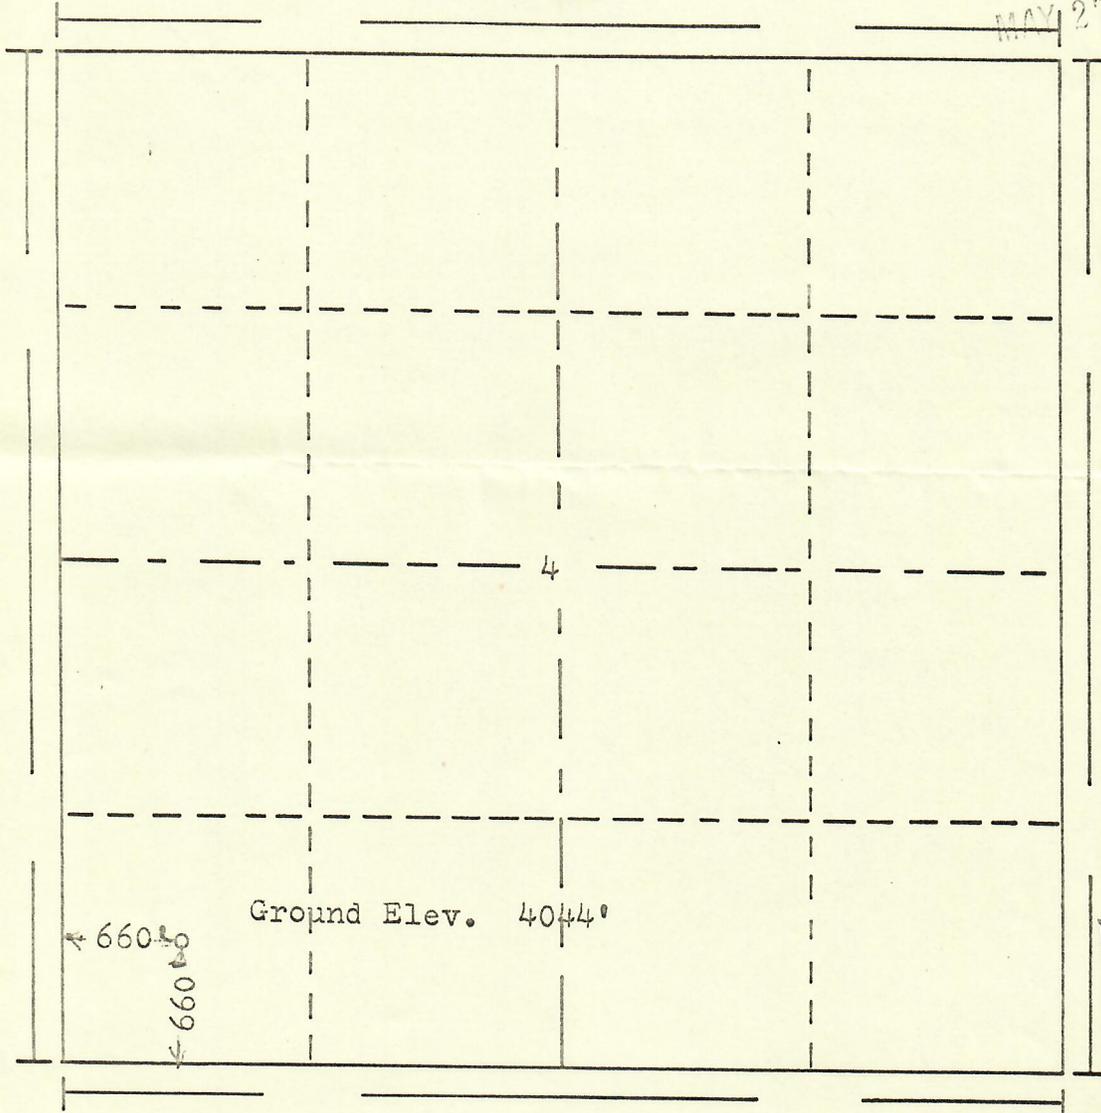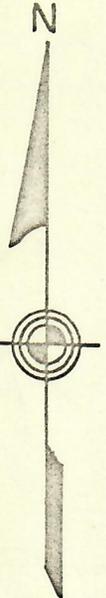

T. 7 N

DWR	
FJP	
HHM	
JAM	
LD	

Scale... 1" = 1000'

Powers Elevation Company, Inc. of Denver, Colorado  
 has in accordance with a request from Carol Jimerson  
 for R.G. Boekel  
 determined the location of No. 14-4 Fuesz  
 to be CSW SW Section 4 Township 7N  
 Range 47W of the 6th Principal Meridian  
 Phillips County, Colorado

I hereby certify that this plat is an  
 accurate representation of a correct  
 survey showing the location of

Date: 5-21-68

B. G. Holloway  
 Licensed Land Surveyor No. 2853  
 State of Colorado