

CERTIFICATE OF SURVEY
for
Union Oil Co. of Calif.
Logan County, Colorado




00250802

RECEIVED

OCT 31 1972

COLD. OIL & GAS CONS. COMM.

T9N R52W 6PM

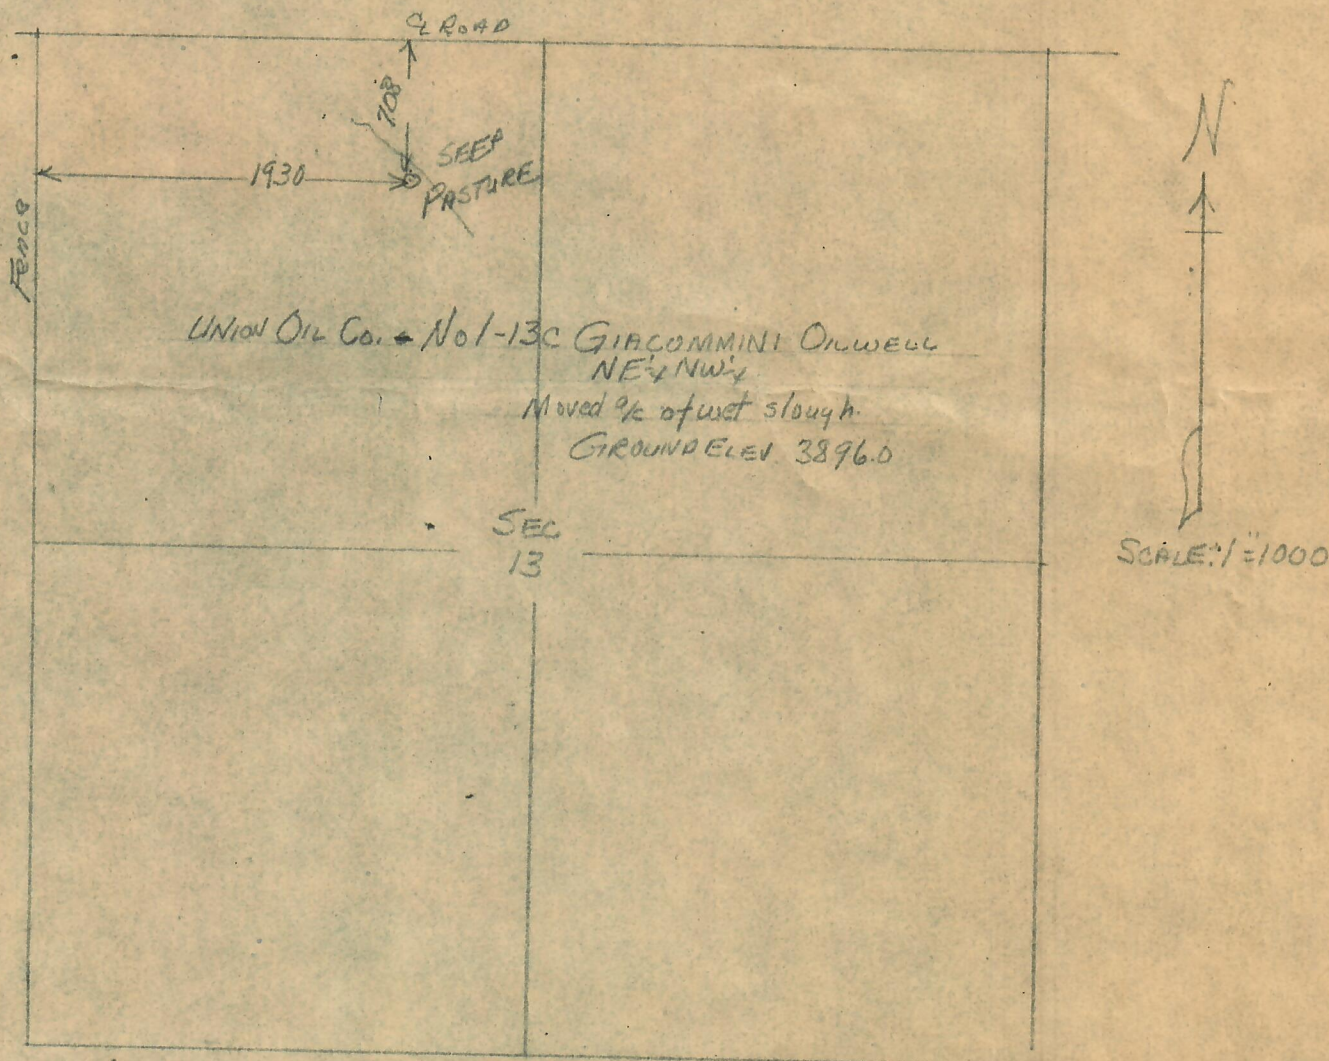

I hereby certify that the above plat is an accurate representation of a correct survey showing the location of Union Oil Co.-No.1-13 Giacommini Oilwell in NE 1/4 NW 1/4 Sec.13 T9N R52W 6PM. The elevation of the ground at the stake is 3896.0 feet above sea level from U.S.G.S. Bench Mark.

Fort Morgan, Colorado
Oct. 29, 1972

Laurel J. Osborne
Registered Professional Engineer
State of Colorado