


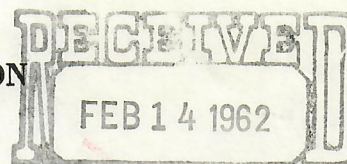

00818253

OIL AND GAS CONSERVATION COMMISSION  
OF THE STATE OF COLORADO

## NOTICE OF INTENTION TO DRILL

OIL & GAS  
CONSERVATION COMMISSION

## INSTRUCTIONS:

A notice of intention to drill a well shall be filed in duplicate on all Federal and Patented lands, and in triplicate on all State lands. Do not begin operations until approved copy has been received. It is mandatory that the proposed location comply with all rules and regulations of the Commission. Locate well on section grid in proper location, and indicate extent of lease. Unless operations are commenced within 180 days after the date of approval hereof, this approval to drill will become null and void.

Name of Operator Stuarco - Dow & McHugh - Murfin Phone No. MA 3-0283  
Address 2117 First Nat'l Bank Bldg. City Denver 2, State Colorado


How is liability secured: Well Bond (Attached) ☐; Blanket Bond ☐; Waiver ☒  
(Check one)

Lease Name Gillham

Well No. 1

Field Name Padroni Wildcat ☐

County Logan

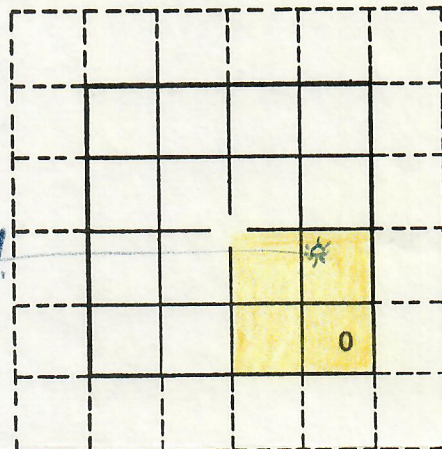

Location SE SE (quarter quarter) Section 8 Township 9N Range 52W Meridian 6th P.M.  
660 feet from South Section line and 660 feet from East Section Line  
N or S E or W

The well is located on: Patented land ☒ State land ☐ Federal land ☐

The well is located within a spaced area: Yes ☒ No ☐

Distance from proposed location to nearest property or lease line 660 feet.

Distance from proposed location to nearest drilling unit line 660 feet.

Objectives: "D" Depth 4700' ; "J" Depth 4800'  
Formation Estimate Formation Estimate

Proposed length of surface casing 150 feet.

REMARKS:

|      |  |
|------|--|
| AJJ  |  |
| DVR  |  |
| WRS  |  |
| HHM  |  |
| JAM  |  |
| EJP  |  |
| JJD  |  |
| FILE |  |

|          |                     |
|----------|---------------------|
| Agent    | <u>GA</u>           |
| Bond     | <u>waived</u>       |
| Spot     | <u>Plat 2-14-62</u> |
| 600 ft   | <u>ord 187</u>      |
| 1200 ft. |                     |
| Wells    |                     |
| Oil      |                     |
| Gas      |                     |
| Status   |                     |

I/We hereby swear (or affirm) that the statements herein made are a full and correct report.

APPROVED:

Date FEB 14 1962

A. J. Gerain  
Director

Company STUARCO OIL COMPANY, INC. Date 2-13-62

Address 2117 First Nat'l Bank Bldg. Phone No. MA 3-0283

By Robert Chancellor Title District Manager  
Signature