

MORRISON LAND COMPANY LEASE

RECEIVED

OCT 22 1981


COLO. OIL & GAS CONS. COMM.

T7N, R48W, 6th P.M.


CERTIFICATE

This is to certify that the above plat was prepared from field notes of actual surveys made by me or under my supervision and that the same are true and correct to the best of my knowledge and belief.


*William Smith*  
REGISTERED LAND SURVEYOR  
REGISTRATION No. 2524  
STATE OF COLORADO

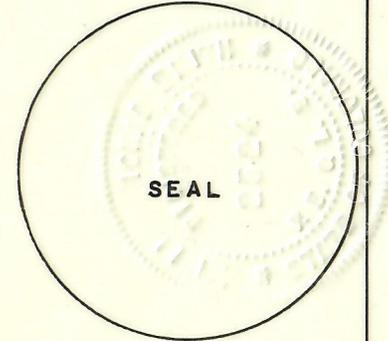

BEST COPY AVAILABLE

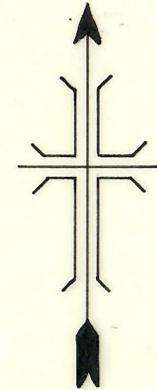

MORRISON LAND CO. 1-14	
C.S.G. EXPLORATION	
T7N, R48W, S14, SE 1/4, SE 1/4	
LOGAN COUNTY, COLORADO	
Scale 1" = 1,000'	Date 10/4/81
Party SJW FWW	X Surveyed Point • Reference Stal (150° N, 150° E)
Drawn by JJ	

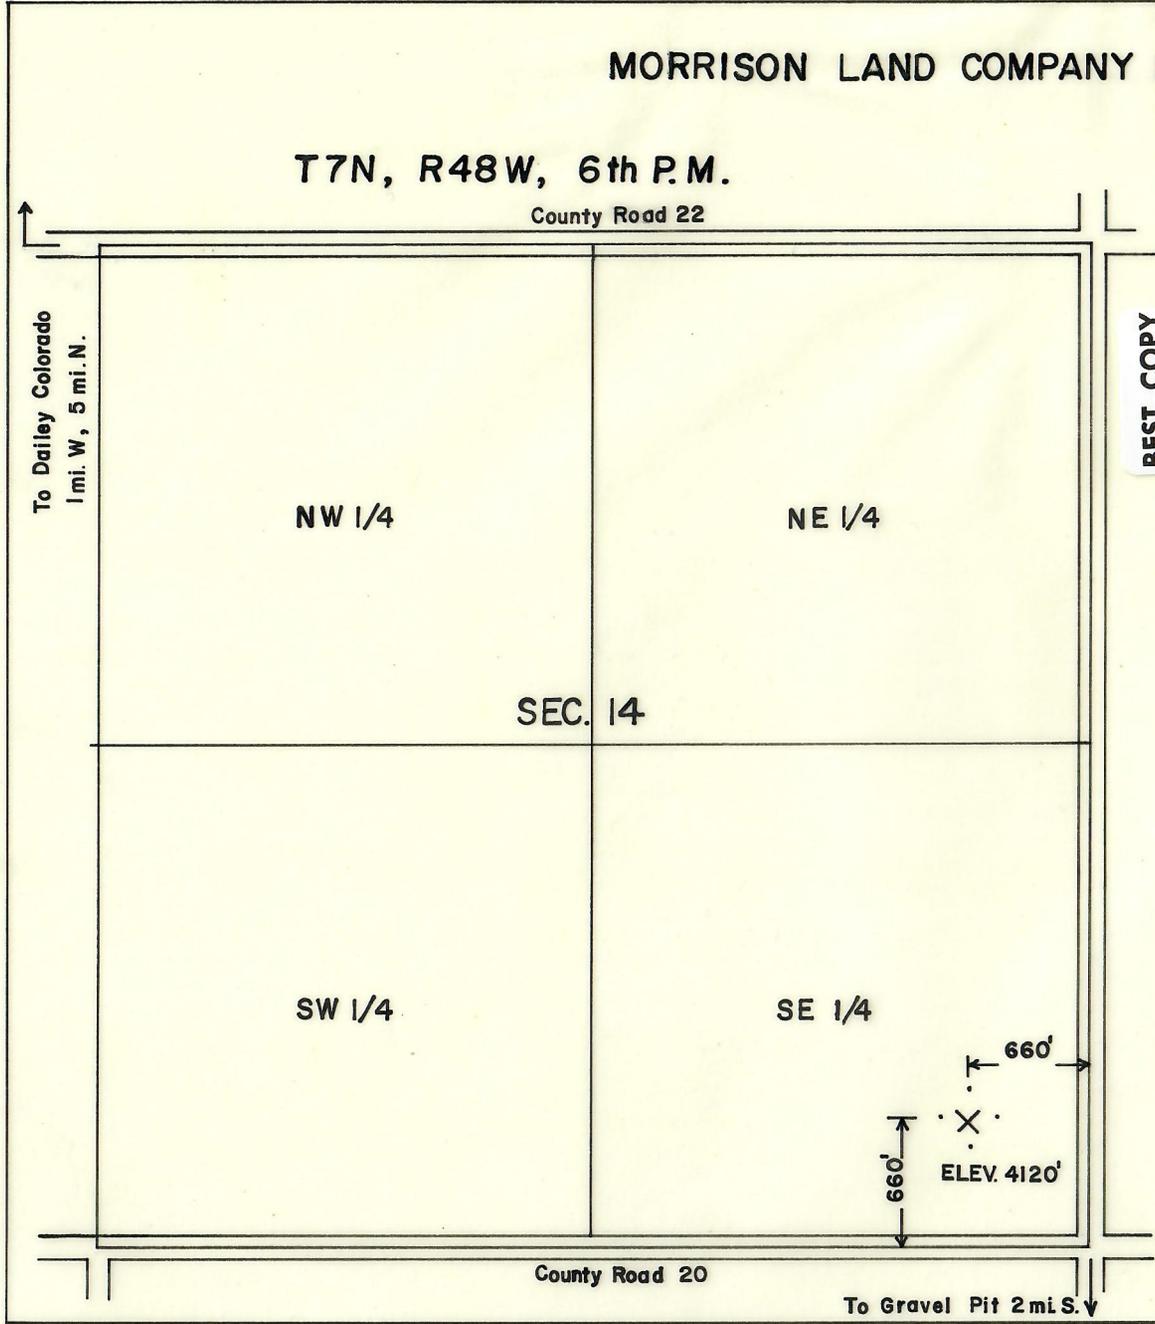

To Dailey Colorado  
1 mi. W, 5 mi. N.

County Road 22

NW 1/4

NE 1/4

SEC. 14

SW 1/4

SE 1/4

660'  
X  
ELEV. 4120'  
660'

County Road 20

To Gravel Pit 2 mi. S.