




BEST IMAGE
AVAILABLE

RECEIVED

JAN 10 1967

COLO. OIL & GAS CONS. COMM

R. 52 W

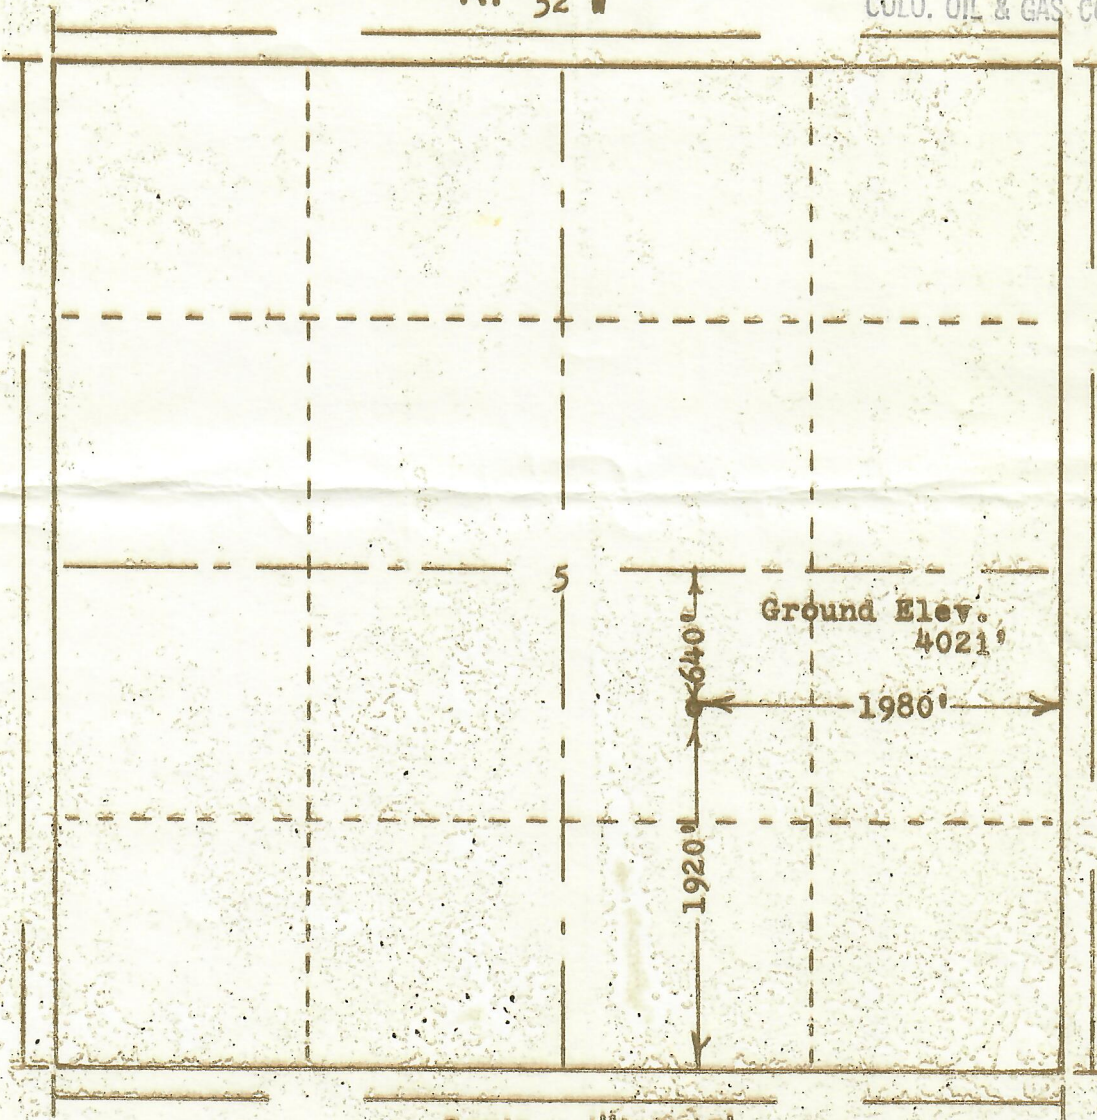

Scale ... 1" = 1000'

Powers Surveyors, Inc. of Denver, Colorado
has in accordance with a request from Mr. Gear
for South Texas Development, Buffalo Oil Corp. &
Braden-Gear Drilling Co. determined the
Location of No. 1 Call
to be C NW SE Section 5 Township 9 North
Range 52 West of the 6th Principal Meridian
Logan County, Colorado

I hereby certify that this plat is an
accurate representation of a correct
survey showing the location of

Date: 12-13-66

Eric G. Hallman
Licensed Land Surveyor No. 2853
State of Colorado

BEST IMAGE
AVAILABLE

66-518