


OIL AND GAS CONSERVATION COMMISSION
OF THE STATE OF COLORADO

NOTICE OF INTENTION TO DRILL

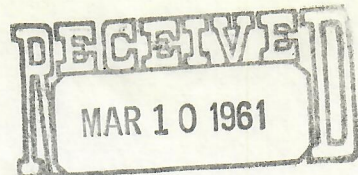


INSTRUCTIONS:

A notice of intention to drill a well shall be filed in duplicate on all Federal and Patented lands, and in triplicate on all State lands. Do not begin operations until approved copy has been received. It is mandatory that the proposed location comply with all rules and regulations of the Commission. Locate well on section grid in proper location, and indicate extent of lease. Unless operations are commenced within 180 days after the date of approval hereof, this approval to drill will become null and void.

Name of Operator Sinclair Oil & Gas Company Phone No. AM 6-2460
Address 601 Denver Club Building City Denver 2, State Colorado

How is liability secured: Well Bond (Attached) ☐; Blanket Bond ☒; Waiver ☐
(Check one)

Lease Name Francis Parke
Well No. 4
Field Name West Padroni Wildcat ☐
County Logan

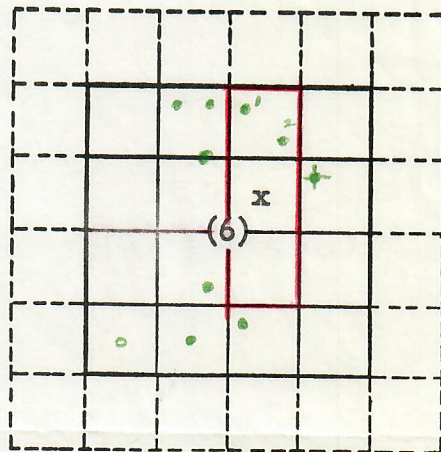

Location SW/4 NE/4 Section 6 Township 9N Range 52W Meridian 6th PM
(quarter quarter)
1980 feet from N Section line and 1980 feet from E Section Line
N or S E or W

The well is located on: Patented land ☒ State land ☐ Federal land ☐

The well is located within a spaced area: Yes ☒ No ☐

Distance from proposed location to nearest property or lease line 660 feet.
Distance from proposed location to nearest drilling unit line 660 feet.

Objectives: Dakota Depth 5150 ; Estimate Formation Estimate Depth Estimate

Proposed length of surface casing 250 feet.

REMARKS:

Agent	
Band	
Spot Plotted	3/10/61
600 ft.	
1200 ft.	
Wells	
Oil	
Gas	
Status	

I/We hereby swear (or affirm) that the statements herein made are a full and correct report.

APPROVED:

Date MAR 10 1961

A. J. Gossin
Director

Company Sinclair Oil & Gas Co. Date 3-8-61

Address 601 Denver Club Bldg., Phone No. AM 6-2460

By R. W. Newport Title Division Chief
Signature Clerk - Production
Department