

CERTIFICATE OF SURVEY  
for  
Patrick A. Doheny  
Logan County, Colorado


RECEIVED

JUN 4 1971

COLO. OIL & GAS CONS. COMM.



00238108

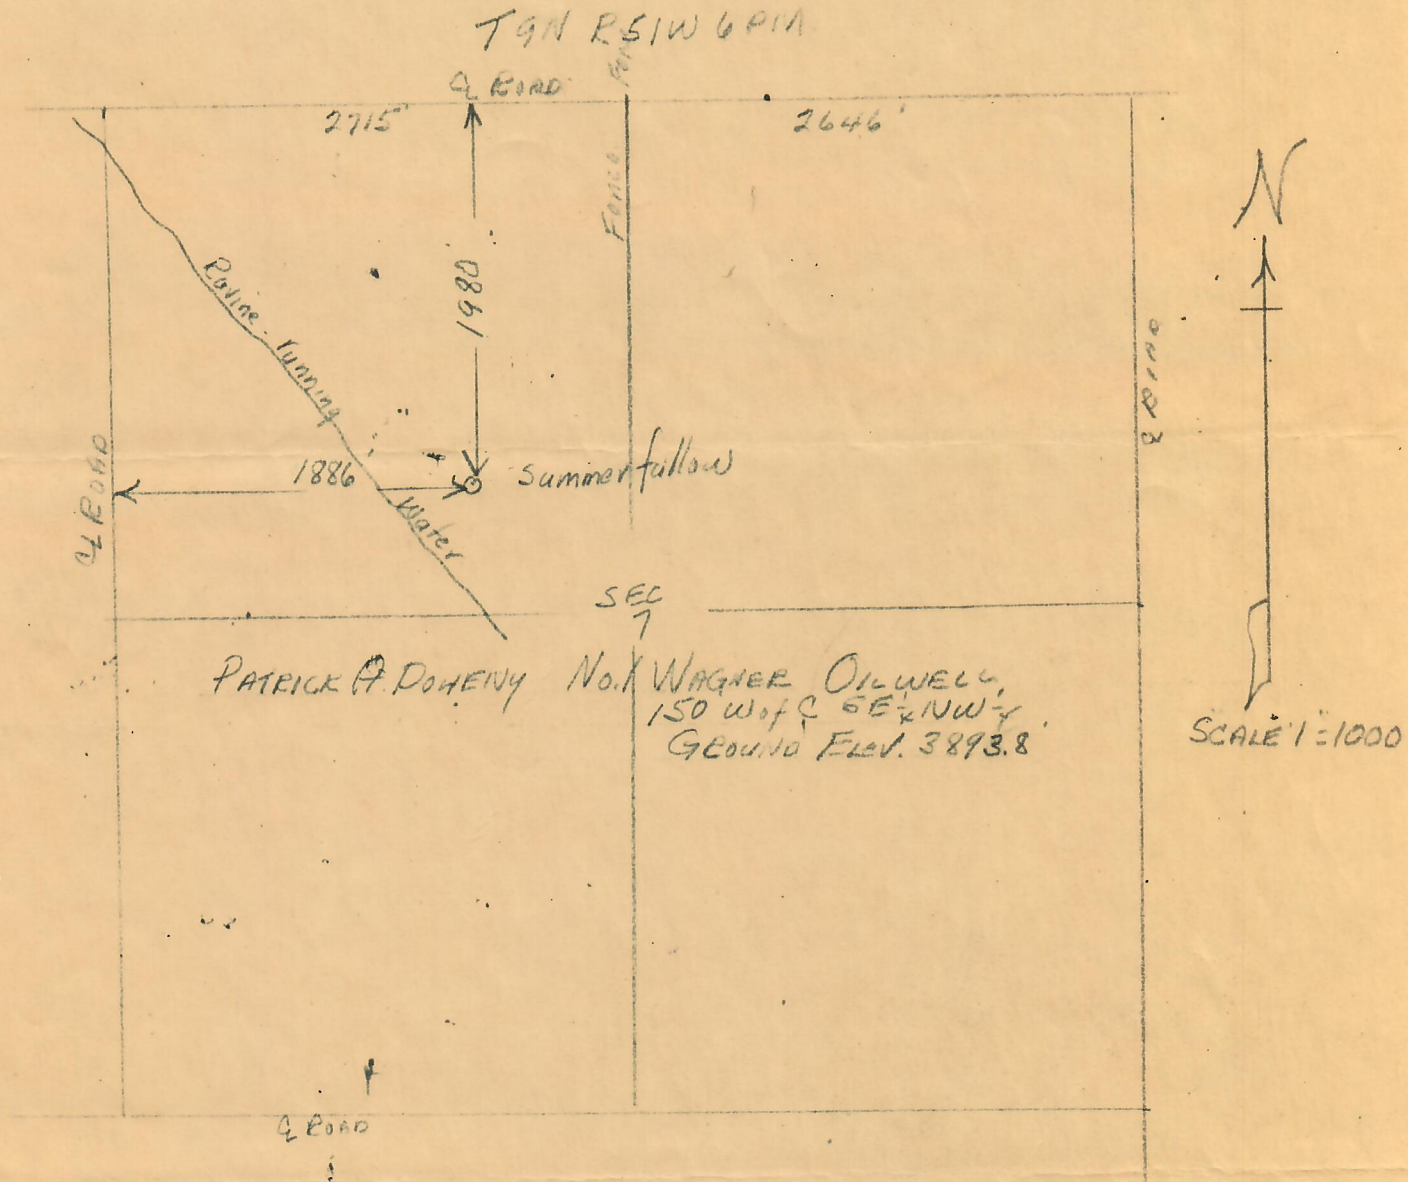

I hereby certify that the above plat is an accurate representation of a correct survey showing the location of Patrick A. Doheny-No.1 Wagner Oilwell 150 feet west of C SE 1/4 NW 1/4 Sec. 7 T9N R51W 6PM. The elevation of the ground at the stake is 3893.8 feet above sea level from U.S.G.S. Bench Mark.

Fort Morgan, Colorado  
May 30, 1971

*David J. Osborne*  
Registered Professional Engineer  
State of Colorado

71-374