


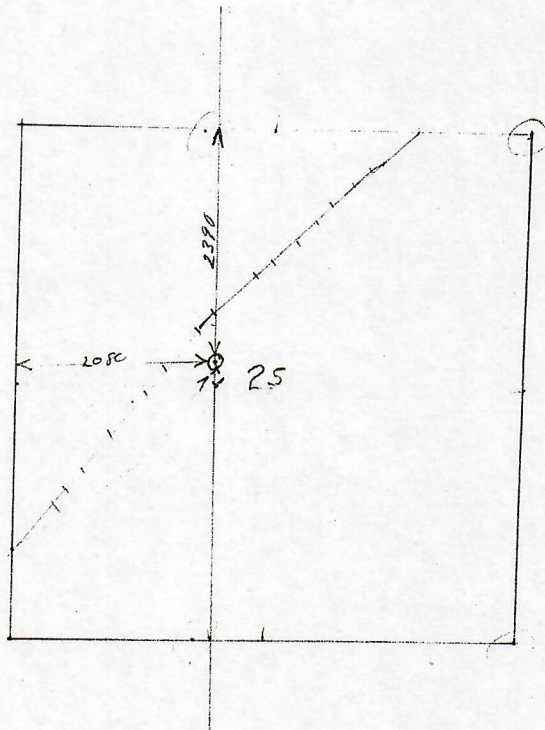

00818062

25-9N-52W



250

