

Interoffice OGCC-1
Rev. 10/1/61




VERBAL REQUESTS

NOTICE OF INTENTION TO DRILL X

Bonding Status waived

NOTICE OF INTENTION TO ABANDON _____

OTHER _____

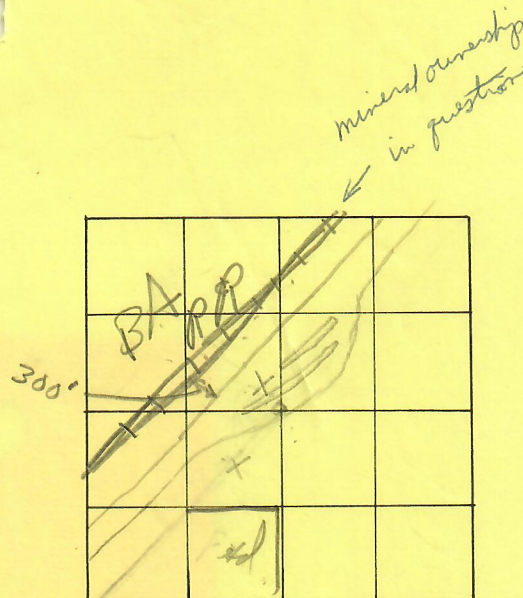

COMPANY Falcon Seaboard ADDRESS _____

WELL NO. 1 BY Cliff Nolte PHONE NO. 29589
Extension _____

LEASE De Soto TITLE _____

COUNTY Logan FIELD W/C

Location SE NW Section 25 Township 9N Range 52W Meridian 6E

(Quarter-Quarter)

2390 feet from N Section line and 2080 feet from W Section line
N or S E or W

2640
250
2390

ESTIMATED DATE OF WORK 11/24/61 ESTIMATED TIME more in

DETAILS OF PLAN OF WORK T.D. 4700 FORMATION Spall

SURFACE CASING minimum 90 feet

600 feet of right of way P.R.
600 feet from lease or property lines
332 from SE line of P.R. right of way

Pending waiver from B-A

APPROVED BY W.P. Smith

DATE 11/30/61

VERBAL REQUESTS

Info Office 0000-1
Rev 10/1/81

